

MARSHALL

~~5-24-71~~  
M-25  
5-24-71

MISSISSIPPI  
BOARD OF WATER COMMISSIONERS  
416 North State Street  
Jackson, Mississippi 39201

**CODED**

WATER WELL DRILLERS LOG

MARSHALL  
*Fate*

5-24-1971 date well completed      Bob Smith firm name      county well located

LANDOWNER:	description of formations encountered	from	to
A. Q. Robute	Topsoil	0	10
<i>Andrybae, Miss.</i> (mailing address)	blue clay	10	60
WELL LOCATION:	white clay	60	120
sec. 25 T. 4 N. R. 5 E.	Fine sand	120	200
<del>1</del> SW <del>10</del> <sup>10</sup> <del>10</del> <sup>10</sup> <del>10</del> <sup>10</sup>	waste sand	160	200
(distance) miles (direction) of (nearest town)			
WELL PURPOSE: <i>None</i> (home, irrigation, municipal, industrial)			
WELL COMPLETION DATA:			
(1) diameter (inches) <u>4</u>			
(2) total depth (feet) <u>200</u>			
(3) static water level (feet) <u>120</u> below above top of ground.			
(4) casing <u>Plastic</u> , <u>200</u> (material) (depth)			
(size) if telescope see back.			
(5) screen <u>20</u> , <u>180</u> (length) (depth to top)			
(size) <u>4</u> , <u>Plastic</u> (material)			
(6) pump <u>1</u> , <u>20</u> (HP) (yield gpm)			
<u>E. M.</u> (type power)			
(7) electric log <u>no</u> (yes or no)			
(organization running log)			
(8) how well bottom plugged <u>plugged</u>			
DRILLERS REMARKS:			


**CODED**

AUG 6 - 1971

MISS. Bd. of  
WATER COMMISSIONERS

If well telescopes please sketch and show depths.

GROUND LEVEL

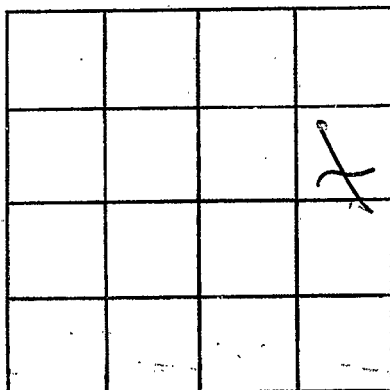

SECTION \_\_\_\_\_

Please indicate well location X.

ADDITIONAL INFORMATION

If more than one screen, show locations of each on sketch.