

**MARSHALL**  
**M 27**  
**8-28-71**

MISSISSIPPI  
 BOARD OF WATER COMMISSIONERS  
 416 North State Street  
 Jackson, Mississippi 39201

**CODED**  
 ALL

**WATER WELL DRILLERS LOG**

8-28-1971 date well completed      Bob Smith firm name      county well located

LANDOWNER:	description of formations encountered	from	to
Leo Torture	Top Soil	0	5
Independence, Miss. (mailing address)	red clay	5	20
WELL LOCATION: sec. 15 T. 4 N. R. 5 E. 8 miles east of Indp. (distance) (direction) (nearest town)	red sand &	20	40
WELL PURPOSE: (home, irrigation, municipal, industrial)	red gravel	40	50
WELL COMPLETION DATA: (1) diameter (inches) 4	white clay	50	70
(2) total depth (feet) 150	white sand	70	150
(3) static water level (feet) 100 below top of ground.			
(4) casing (material) Plastic, (depth) 150			
(5) screen (length) 20, (depth to top) 130			
(6) pump (HP) 3/4, (yield gpm) 15			
(7) electric log (yes or no) no			
(8) how well bottom plugged plugged			
DRILLERS REMARKS:			


**CODED**

NOV 9 2 1971

MISS. Bd. OF  
 WATER COMMISSIONERS

If well telescopes please sketch and show depths.

GROUND LEVEL

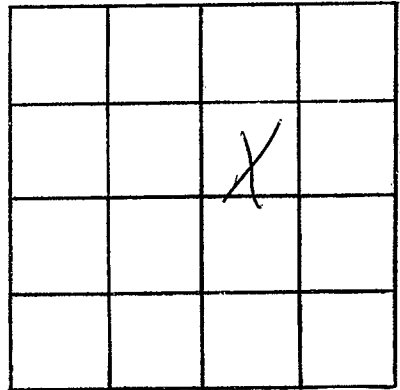

SECTION \_\_\_\_\_

Please indicate well location X.

ADDITIONAL INFORMATION

If more than one screen, show locations of each on sketch.