

MARSHALL
M28
8-28-71

MISSISSIPPI
 BOARD OF WATER COMMISSIONERS
 416 North State Street
 Jackson, Mississippi 39201
 WATER WELL DRILLERS LOG

CODED
 MARSHALL

8-28-1971
 date well completed

Bob Smith
 firm name

county well located

LANDOWNER:	description of formations encountered	from	to
Leo Fortune <i>(mailing address)</i>	top soil	0	5
	red clay	5	20
	red sand	20	40
	red gravel	40	50
	white clay	50	70
	white sand	70	100
	coarse sand	100	170
WELL LOCATION: sec. <u>15</u> T. <u>4</u> N. R. <u>5</u> E. <u>(W)</u> <u>8</u> miles <u>east</u> of <u>Ind</u> <i>(distance) (direction) (nearest town)</i>			
WELL PURPOSE: <u>Home</u> <i>(home, irrigation, municipal, industrial)</i>			
WELL COMPLETION DATA:			
(1) diameter (inches) <u>4</u>			
(2) total depth (feet) <u>170</u>			
(3) static water level (feet) <u>100</u> below above top of ground.			
(4) casing <u>Plastic</u> , <u>170</u> <i>(material) (depth)</i>			
<u> </u> if telescope see back. <i>(size)</i>			
(5) screen <u>20</u> , <u>150</u> <i>(length) (depth to top)</i>			
<u>4</u> , <u>Plastic</u> <i>(size) (material)</i>			
(6) pump <u>3/4</u> , <u>15</u> <i>(HP) (yield gpm)</i>			
<u>Elec.</u> <i>(type power)</i>			
(7) electric log <u>no</u> <i>(yes or no)</i>			
<u> </u> <i>(organization running log)</i>			
(8) how well bottom plugged <u>plugged</u>			
DRILLERS REMARKS:			


CODED

NOV 22 1971

MISS. Bd. of
 WATER COMMISSIONERS

If well telescopes please sketch and show depths.

GROUND LEVEL

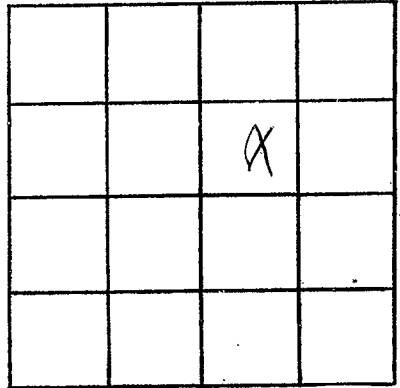

SECTION _____

Please indicate well location X.

ADDITIONAL INFORMATION

If more than one screen, show locations of each on sketch.