

MARSHALL
M 29
1-72

MISSISSIPPI
 BOARD OF WATER COMMISSIONERS
 416 North State Street
 Jackson, Mississippi 39201

WATER WELL DRILLERS **CODED**

G. and H. Well Company Marshall

19 date well completed firm name county well located

LANDOWNER:	description of formations encountered	from	to
Charlie Newson	Red Clay	1	15
Miss,	White Clay	15	20
Route 2 Box 159, Coldwater, Miss	Black Clay	20	30
(mailing address)	Black Clay	30	40
WELL LOCATION:	Black Clay	40	50
sec. 34 T 4 N R 5 E	Black Clay and White Clay	50	60
16 miles East Senatobia	Sand and White Clay	60	70
(distance) (direction) of (nearest town)	White Sand	70	80
WELL PURPOSE: home	White Sand	80	90
(home, irrigation, municipal, industrial)	White Sand	90	100
WELL COMPLETION DATA:	White Sand	100	110
(1) diameter (inches) 4 inch	White Sand	110	120
(2) total depth (feet) 160	White Sand	120	130
(3) static water level (feet) 50 below top of ground.	White Sand	130	140
(4) casing Plastic, 160 (material) (depth)	White Sand	140	150
(size) if telescope see back.	White Sand	150	160
(5) screen 5 ft., 15 ft. (length) (depth to top)			
4 in., Gravel (size) (material)			
(6) pump 3/4/ 10 GPM (HP) (yield gpm)			
Electric 220 (type power)			
(7) electric log No (yes or no)			
(organization running log)			
(8) how well bottom plugged Cap			
DRILLERS REMARKS:			


CODED

JAN 29 1972

MISS. BD. OF WATER COM.

If well telescopes please sketch and show depths.

GROUND LEVEL

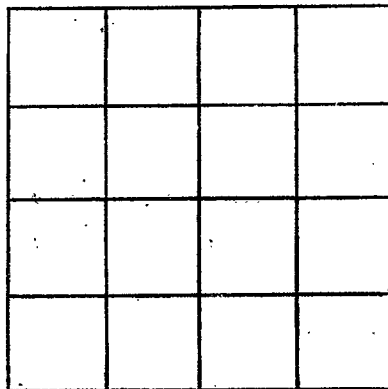

SECTION _____

Please indicate well location X.

ADDITIONAL INFORMATION

If more than one screen, show locations of each on sketch.