

MARSHALL  
M31  
7-72

MISSISSIPPI  
BOARD OF WATER COMMISSIONERS  
416 North State Street  
Jackson, Mississippi 39201

**CODED**

WATER WELL DRILLERS LOG

*Atkinson & Frost Marshall*

19 date well completed

firm name

county well located

LANDOWNER:

*Johanna Newsome*  
*Byrdline Miss*  
(mailing address)

description of formations encountered

from

to

*clay* 0 30  
*sand* 30 75  
*white sand* 75 110

WELL LOCATION:

sec. 4 T. 4 N. R. 3 E.  
8 miles 3 of Byrdline  
(distance) (direction) (nearest town)

WELL PURPOSE:

(home, irrigation, municipal, industrial)

WELL COMPLETION DATA:

- (1) diameter (inches) 4"
- (2) total depth (feet) 110
- (3) static water level (feet) 70 below top of ground.
- (4) casing P.V.C. (material), (depth) \_\_\_\_\_ (size) if telescope see back.
- (5) screen 5ft, 105 (length) (depth to top) 4" P.V.C. (size) (material)
- (6) pump 3/4 (HP) 10 (yield gpm)  
elec (type power)
- (7) electric log \_\_\_\_\_ (yes or no)

**CODED**

(organization running log)

(8) how well bottom plugged cap


JUL 12 1972

DRILLERS REMARKS:

BRING  
DATE

If well telescopes please sketch and show depths.

GROUND LEVEL

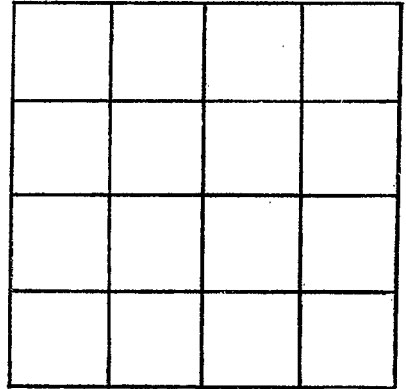

SECTION \_\_\_\_\_

Please indicate well location X.

ADDITIONAL INFORMATION

If more than one screen,  
show locations of each on sketch.