

MARSHALL
M 33
2-26-72

MISSISSIPPI
BOARD OF WATER COMMISSIONERS
416 North State Street
Jackson, Mississippi 39201

CODED

WATER WELL DRILLERS LOG

Feb. 26 1972 R. L. Carpenter Marshall
date well completed firm name county well located


LANDOWNER:	description of formations encountered	from	to
<u>Jones Westbrook</u> <u>Small Hill, Miss</u> <u>RFD</u> (mailing address)	<u>Surface Soil</u>	<u>0</u>	<u>18</u>
WELL LOCATION: sec. <u>23</u> T. <u>4</u> N. R. <u>5</u> E. <u>1/2</u> miles <u>S</u> of <u>Small Hill</u> (W) (distance) (direction) (nearest town)	<u>Med. white sand</u>	<u>18</u>	<u>63</u>
WELL PURPOSE: <u>Home</u> (home, irrigation, municipal, industrial)	<u>White clay</u>	<u>63</u>	<u>75</u>
WELL COMPLETION DATA:	<u>Fine white sand</u>	<u>75</u>	<u>102</u>
(1) diameter (inches) <u>4</u>	<u>White coarse sand</u>	<u>102</u>	<u>128</u>
(2) total depth (feet) <u>128</u>	CODED		
(3) static water level (feet) <u>80</u> below above top of ground.			
(4) casing <u>Plastic</u> , <u>122 ft</u> (material) (depth) <u>12</u> if telescope see back. (size)			
(5) screen <u>6 ft</u> , <u>122 ft</u> (length) (depth to top)			
(6) pump <u>3/4</u> , <u>10</u> (HP) (yield gpm) <u>Elec</u> (type power)			
(7) electric log <u>no</u> (yes or no)			
(8) how well bottom plugged <u>Plastic Plug</u> (organization running log)			
DRILLERS REMARKS:			

ALL 4 65572

MISS. BD. OF
WATER COMM.

If well telescopes please sketch and show depths.

GROUND LEVEL

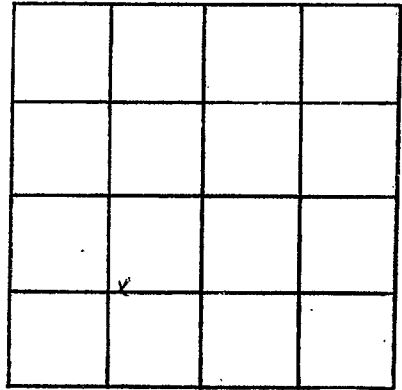

SECTION 23

Please indicate well location X.

ADDITIONAL INFORMATION

A series of horizontal lines for writing additional information, starting below the 'ADDITIONAL INFORMATION' header and extending down to the bottom of the page.

If more than one screen, show locations of each on sketch.