

MARSHALL
M 35
10-25-72

MISSISSIPPI
 BOARD OF WATER COMMISSIONERS
 416 North State Street
 Jackson, Mississippi 39201
WATER WELL DRILLERS LOG

CODED

10-25
 date well completed

1972 HICKS BROTHERS
 firm name

MARSHAL
 county well located


LANDOWNER: <u>JAMES H Middlebrook</u>	description of formations encountered	from	to
<u>2426 PECAN Circle</u>	<u>Red Clay</u>	<u>0</u>	<u>25</u>
<u>Memphis TENN</u> (mailing address)	<u>Red sand</u>	<u>25</u>	<u>75</u>
WELL LOCATION:	<u>White clay</u>	<u>75</u>	<u>115</u>
sec. <u>36</u> T. <u>4</u> N. R. <u>5</u> E.	<u>White sand</u>	<u>115</u>	<u>175</u>
<u>16</u> miles <u>N.E.</u> of <u>Holly Springs</u> (distance) (direction) (nearest town)			
WELL PURPOSE: <u>HOME</u> (home, irrigation, municipal, industrial)			
WELL COMPLETION DATA:			
(1) diameter (inches) <u>4"</u>			
(2) total depth (feet) <u>175</u>			
(3) static water level (feet) <u>140</u> below top of ground.			
(4) casing <u>Plastic</u> , <u>169</u> (material) (depth)			
(size) If telescope see back.			
(5) screen <u>6"</u> , <u>169"</u> (length) (depth to top)			
<u>4"</u> , <u>Gravel & Plastic</u> (size) (material)			
(6) pump <u>1</u> , <u>10</u> (HP) (yield gpm)			
<u>220 Elec</u> (type power)			
(7) electric log <u>NO</u> (yes or no)			
(organization running log)			
(8) how well bottom plugged <u>CAP</u>			
DRILLERS REMARKS:			

CODED

OCT 27 1972

If well telescopes please sketch and show depths.

GROUND LEVEL

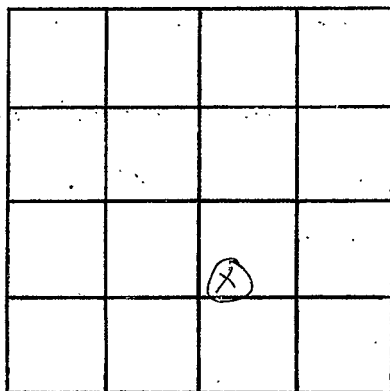

SECTION _____

Please indicate well location X.

ADDITIONAL INFORMATION

If more than one screen,
show locations of each on sketch.