

MISSISSIPPI
BOARD OF WATER COMMISSIONERS
416 North State Street
Jackson, Mississippi 39201

CODED

MARSHALL
M37
12-2-72

WATER WELL DRILLERS LOG

marshall

12-2-1972 date well completed Bob Smith firm name county well located

LANDOWNER:
Earnest Rich
Snatchie, miss.
(mailing address)

description of formations encountered	from	to
<i>clay sint</i>		<i>6</i>
<i>gravel</i>	<i>6</i>	<i>10</i>
<i>red sand</i>	<i>10</i>	<i>17</i>
<i>red clay</i>	<i>10</i>	<i>30</i>
<i>red sand</i>	<i>30</i>	<i>60</i>

WELL LOCATION:
sec. 34 T 4 N R 5 E
(S) (W)
1 1/2 miles *South* of *Wall Hill*
(distance) (direction) (nearest town)

WELL PURPOSE: *Home*
(home, irrigation, municipal, industrial)

<i>white sand</i>	<i>60</i>	<i>140</i>
<i>blue clay</i>	<i>140</i>	<i>155</i>
<i>white sand</i>	<i>155</i>	<i>206</i>

WELL COMPLETION DATA:

- (1) diameter (inches) 4
- (2) total depth (feet) 206
- (3) static water level (feet) 155 below above top of ground.
- (4) casing *P. latic* 206
(material) (depth)
 if telescope see back.
(size)
- (5) screen 20 186
(length) (depth to top)
4 *Plastic*
(size) (material)
- (6) pump 1/2 10
(HP) (yield gpm)
Elec.
(type power)
- (7) electric log *no*
(yes or no)

(organization running log)

CODED


(8) how well bottom plugged *plugged*

DRILLERS REMARKS:

FEB 28 1973

If well telescopes please sketch and show depths.

GROUND LEVEL

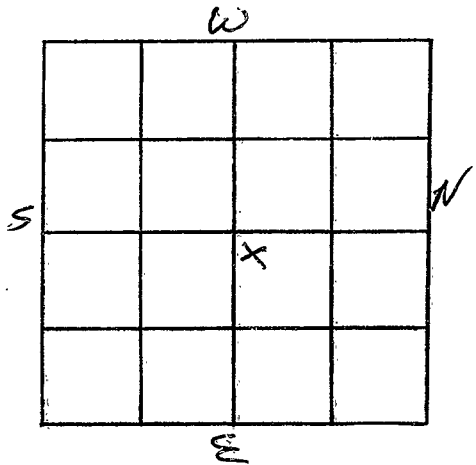

SECTION 34

Please indicate well location X.

ADDITIONAL INFORMATION

If more than one screen,
show locations of each on sketch.