

MARSHALL
M 38
3-73

MISSISSIPPI
 BOARD OF WATER COMMISSIONERS
 416 North State Street
 Jackson, Mississippi 39201

CODED

WATER WELL DRILLERS LOG

date well completed 19 Attleson Frost firm name Marshall county well located

LANDOWNER:
Lawrence City
Byhalia Miss
 (mailing address)

description of formations encountered	from	to
	<u>Clay</u>	<u>0</u>
<u>Red Sand</u>	<u>18</u>	<u>30</u>
<u>White Clay</u>	<u>30</u>	<u>35</u>
<u>Brown Sand</u>	<u>35</u>	<u>60</u>
<u>White Clay</u>	<u>60</u>	<u>70</u>
<u>White Sand</u>	<u>70</u>	<u>95</u>
<u>White Clay</u>	<u>95</u>	<u>110</u>
<u>White sand</u>	<u>110</u>	<u>138</u>

WELL LOCATION:
 sec 5 T 4 N R 5 E
11 miles S of Byhalia
 (distance) (direction) (nearest town)

WELL PURPOSE: home
 (home, irrigation, municipal, industrial)


- WELL COMPLETION DATA:
- (1) diameter (inches) 4"
 - (2) total depth (feet) 138
 - (3) static water level (feet) 95 below above top of ground:
 - (4) casing PVC
 (material) (depth)
 (size) If telescope see back.
 - (5) screen 10 128
 (length) (depth to top)
4" PVC
 (size) (material)
 - (6) pump 1/2 8
 (HP) (yield gpm)
Elec
 (type power)
 - (7) electric log No
 (yes or no)
 (organization running log)
 - (8) how well bottom plugged CAP

CODED

DRILLERS REMARKS:

If well telescopes please sketch and show depths.

GROUND LEVEL

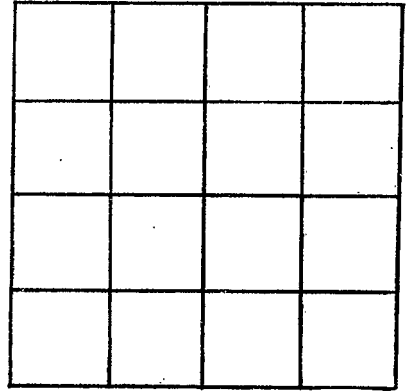

SECTION _____

Please indicate well location X.

ADDITIONAL INFORMATION

If more than one screen, show locations of each on sketch.