

MARSHALL

M 39

4-5-73

MISSISSIPPI BOARD OF WATER COMMISSIONERS
416 North State Street
Jackson, Mississippi 39201

CODED

WATER WELL DRILLERS LOG

4-5-1973 date well completed Bob Smith firm name Marshall county well located

LANDOWNER: Ed Sanders
Wall Hill
(mailing address)

description of formations encountered	from	to
clay sint		15
Red sand	15	50
white sand	50	185

WELL LOCATION:
sec. 25 T 4 N R 5 E
1 1/2 miles East of Wall Hill
(distance) (direction) (nearest town)

WELL PURPOSE: Home
(home, irrigation, municipal, industrial)


- WELL COMPLETION DATA:
- (1) diameter (inches) 4
 - (2) total depth (feet) 185
 - (3) static water level (feet) 12 below top of ground.
 - (4) casing Plastic 185
(material) (depth)
 - (size) If telescope see back.
 - (5) screen 20 165
(length) (depth to top)
 - 4 Plastic
(size) (material)
 - (6) pump 1/3 10
(HP) (yield gpm)
 - Elex
(type power)
 - (7) electric log no
(yes or no)
 - (organization running log)
 - (8) how well bottom plugged plugged

CODED

DRILLERS REMARKS:

If well telescopes please sketch and show depths.

GROUND LEVEL

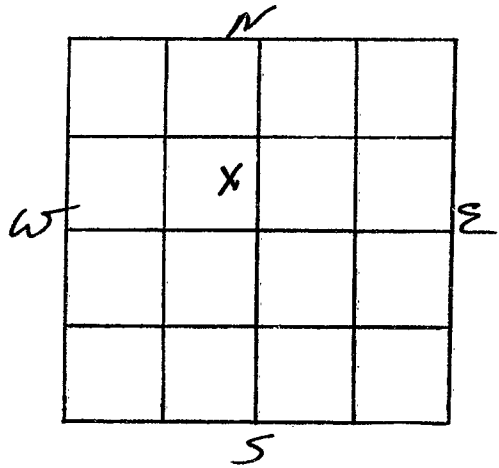

SECTION 25

Please indicate well location X.

ADDITIONAL INFORMATION

If more than one screen,
show locations of each on sketch.