

MARSHALL

M 40

7-23-73

MISSISSIPPI BOARD OF WATER COMMISSIONERS  
416 North State Street  
Jackson, Mississippi 39201

**CODED**

WATER WELL DRILLERS LOG

6-13-73  
date well completed

1973 Dean + Kent Bumpers  
firm name

MARSHALL  
county well located

LANDOWNER:

Gilbert Jenkins Henry  
Shooper for  
Caldwater Rt 2  
(mailing address)

description of formations encountered

from to

clay	0	20
sand	30	50
clay	50	60
rock	60	70
clay	70	75
sand	75	150

WELL LOCATION:

sec. 27 T. 4 N. R. 5 E  
(S) (W)  
2.2 miles west of Nacogdoches  
(distance) (direction) (nearest town)

WELL PURPOSE: (home, irrigation, municipal, industrial)

WELL COMPLETION DATA:

- (1) diameter (inches) 4"
- (2) total depth (feet) 150 feet
- (3) static water level (feet) 11 feet below top of ground.
- (4) casing pvc (material), 150 feet (depth)
- (size) if telescope see back.
- (5) screen 7 ft. (length), 14.3 feet (depth to top)
- 4" gravel waf (size) (material)
- (6) pump 3/4 (HP), 14 (yield gpm)
- (type power)
- (7) electric log (yes or no) (type)
- (organization running log)
- (8) how well bottom plugged 4" cgr


**CODED**

DRILLERS REMARKS:

JUL 10 1973

If well telescopes please sketch and show depths.

GROUND LEVEL

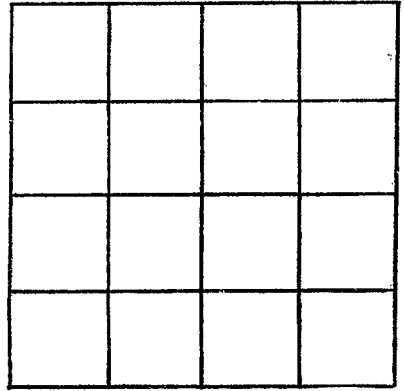

SECTION \_\_\_\_\_

Please indicate well location X.

ADDITIONAL INFORMATION

If more than one screen, show locations of each on sketch.