

MARSHALL
M 41
7-23-73

MISSISSIPPI
 BOARD OF WATER COMMISSIONERS
 416 North State Street
 Jackson, Mississippi 39201

CODED

WATER WELL DRILLERS LOG

6-4 1973 Dean & Kent Bugas well Marshall
 date well completed firm name county well located


LANDOWNER:	description of formations encountered	from	to
Rufus Brown			
Holly Springs, Miss. (mailing address)	sand	30	48
WELL LOCATION: sec. 11 T. 4 N R. 5 E (S) (W)	clay	48	50
6 miles NORTH of MARIONA (distance) (direction) (nearest town)	sand	50	130
WELL PURPOSE: Domestic (home, irrigation, municipal, industrial)			
WELL COMPLETION DATA:			
(1) diameter (inches) 4"			
(2) total depth (feet) 130 feet			
(3) static water level (feet) 50 feet below top of ground.			
(4) casing PVC 130 feet (material) (depth)			
(size) If telescope see back.			
(5) screen 7 feet 123 feet (length) (depth to top)			
4" gravel wall (size) (material)			
(6) pump 3/4 14 (HP) (yield gpm)			
(type power)			
(7) electric log flat. (yes or no)			
(organization running log)			
(8) how well bottom plugged 4" cop.			
DRILLERS REMARKS:			

CODED

3022 10 1973

If well telescopes please sketch and show depths.

GROUND LEVEL

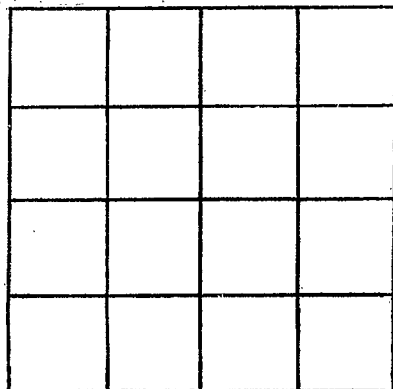

SECTION _____

Please indicate well location X.

ADDITIONAL INFORMATION

If more than one screen, show locations of each on sketch.