

CODED

MARSHALL
M 42
8/73

MISSISSIPPI
BOARD OF WATER COMMISSIONERS
416 North State Street
Jackson, Mississippi 39201

WATER WELL DRILLERS LOG

Watson & Hart Marshall

19 date well completed firm name county well located

LANDOWNER:
WALTER DOCKERY
Byrdia Miss
(mailing address)

description of fomations encountered	from	to
<i>Brown Clay</i>	<i>0</i>	<i>25</i>
<i>Red Sand</i>	<i>25</i>	<i>60</i>
<i>White Sand</i>	<i>60</i>	<i>90</i>
<i>White Clay</i>	<i>90</i>	<i>100</i>
<i>White Sand</i>	<i>100</i>	<i>125</i>

WELL LOCATION:
sec. *4* T. *4* N. R. *5* E.
5 miles (distance) S (direction) of *Watson* (nearest town)

WELL PURPOSE:
(home, irrigation, municipal, industrial)

- WELL COMPLETION DATA:
- (1) diameter (inches) *4 1/2*
 - (2) total depth (feet) *125*
 - (3) static water level (feet) *70* below above top of ground.
 - (4) casing *PVC 125* (material) (depth)
 - (size) If telescope see back.
 - (5) screen *10ft 115* (length) (depth to top)
 - 4"* (size) *PVC* (material)
 - (6) pump *1/2* (HP) *10* (yield gpm)
 - Elec* (type power)
 - (7) electric log *NO* (yes or no)
 - (organization running log)
 - (8) how well bottom plugged *CAP*


CODED

AUG 10 1973

DRILLERS REMARKS:

If well telescopes please sketch and show depths.

GROUND LEVEL

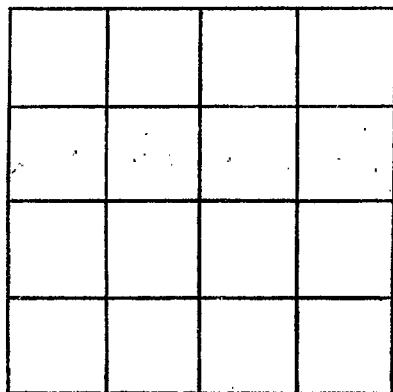

SECTION _____

Please indicate well location X.

ADDITIONAL INFORMATION

If more than one screen, show locations of each on sketch.