

MARSHALL  
M43  
6-16-73

MISSISSIPPI  
BOARD OF WATER COMMISSIONERS  
416 North State Street  
Jackson, Mississippi 39201

CODED

WATER WELL DRILLERS LOG

6-16-1973 *Bob Hill* *Marshall*  
date well completed firm name county well located

LANDOWNER:	description of formations encountered	from	to
<i>O. T. Lane</i>			
<i>Byrd - Min</i> (mailing address)	<i>Red sand</i>	<i>12</i>	<i>45</i>
WELL LOCATION:	<i>White sand</i>	<i>45</i>	<i>170</i>
sec <i>25</i> T <i>4</i> N R <i>5</i> E <i>1 3/4</i> miles <i>SW</i> of <i>Orion</i> (distance) (direction) (nearest town)			
WELL PURPOSE: <i>Home</i> (home, irrigation, municipal, industrial)			
WELL COMPLETION DATA:			
(1) diameter (inches) <i>4</i>			
(2) total depth (feet) <i>170</i>			
(3) static water level (feet) <i>105</i> below top of ground.			
(4) casing <i>Plastic</i> <i>170</i> (material) (depth)			
(size) If telescope see back.			
(5) screen <i>20</i> <i>150</i> (length) (depth to top)			
(size) <i>4</i> <i>Plastic</i> (material)			
(6) pump <i>1/2</i> <i>10</i> (HP) (yield gpm)			
(type power) <i>Electric</i>			
(7) electric log <i>no</i> (yes or no)			
(organization running log)			
(8) how well bottom plugged <i>plugged</i>			
DRILLERS REMARKS:			


CODED

SEP 27 1973

MISS.  
BOARD

If well telescopes please sketch and show depths.

GROUND LEVEL

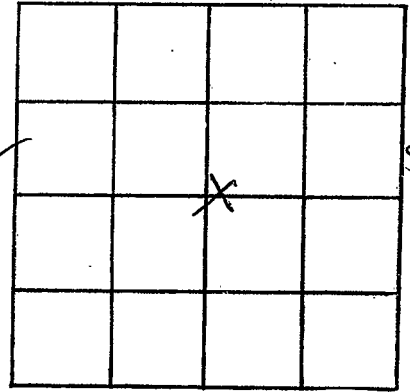

SECTION 25

Please indicate well location X.

ADDITIONAL INFORMATION

If more than one screen, show locations of each on sketch.