

MARSHALL

M44

6-2-73

MISSISSIPPI  
 BOARD OF WATER COMMISSIONERS  
 416 North State Street  
 Jackson, Mississippi 39201

CODED

WATER WELL DRILLERS LOG

6-2-1973 date well completed      Bob Smith firm name      Marshall county well located

LANDOWNER: Joe Wilkerson  
 Wall Hill  
 (mailing address)

description of formations encountered	from	to
clay dirt	0	10
yellow clay	10	14
white sand	14	70
blue clay	70	98
coarse white sand	98	140

WELL LOCATION:  
 sec. 13 T. 4 N. R. 5 E. S. W.  
 3 1/2 miles NE of Wall Hill  
 (distance) (direction) (nearest town)

WELL PURPOSE: none  
 (home, irrigation, municipal, industrial)

- WELL COMPLETION DATA:
- (1) diameter (inches) 4
  - (2) total depth (feet) 140
  - (3) static water level (feet) 70 below top of ground.
  - (4) casing Plastic 140  
 (material) (depth)
  - \_\_\_\_\_ if telescope see back.  
 (size)
  - (5) screen 20 120  
 (length) (depth to top)
  - 4 Plastic  
 (size) (material)
  - (6) pump 3/4 15  
 (HP) (yield gpm)
  - Elec  
 (type power)
  - (7) electric log no  
 (yes or no)
  - \_\_\_\_\_ (organization running log)
  - (8) how well bottom plugged plugged


CODED

DRILLERS REMARKS:

SEP 27 1973

If well telescopes please sketch and show depths.

GROUND LEVEL

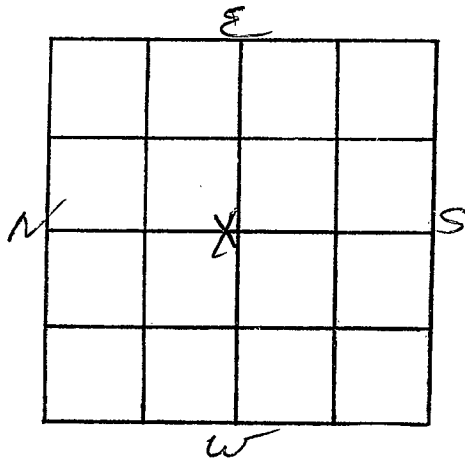

SECTION 12

Please indicate well location X.

ADDITIONAL INFORMATION

If more than one screen,  
show locations of each on sketch.