

MARSHALL
M 49
6-5-74

MISSISSIPPI
 BOARD OF WATER COMMISSIONERS
 416 North State Street
 Jackson, Mississippi 39201

CODED

WATER WELL DRILLERS LOG

6-5 date well completed 1974 Bob Smith & Son firm name Marshall county well located


LANDOWNER: <u>Curry Guy</u>	description of formations encountered	from	to
<u>309 Hwy</u> <u>Byhalia, Miss.</u> (mailing address)			
WELL LOCATION: sec. <u>13</u> T <u>4</u> N R. <u>5</u> E <u>8</u> miles <u>SE</u> of <u>Watson</u> (distance) (direction) (nearest town)	<u>Red sand</u>	<u>15'</u>	<u>60'</u>
WELL PURPOSE: <u>Home</u> (home, irrigation, municipal, industrial)	<u>White sand and clay streaks</u>	<u>60'</u>	<u>100'</u>
WELL COMPLETION DATA: (1) diameter (inches) <u>4</u> (2) total depth (feet) <u>138</u> (3) static water level (feet) <u>77</u> below top of ground. (4) casing <u>Plastic</u> , <u>138</u> (material) (depth) (size) if telescope see back. (5) screen <u>10'</u> , <u>138</u> (length) (depth to top) <u>4</u> , <u>Plastic</u> (size) (material) (6) pump <u>1/3</u> , <u>10</u> (HP) (yield gpm) <u>Electric</u> (type power) (7) electric log <u>no</u> (yes or no) (organization running log) (8) how well bottom plugged <u>plugged</u>	<u>White</u> CODED	<u>100'</u>	<u>138'</u>
DRILLERS REMARKS:			

RECEIVED
RECEIVED
JUL - 5 1974

MISS. BD. OF WATER COMM

If well telescopes please sketch and show depths.

GROUND LEVEL

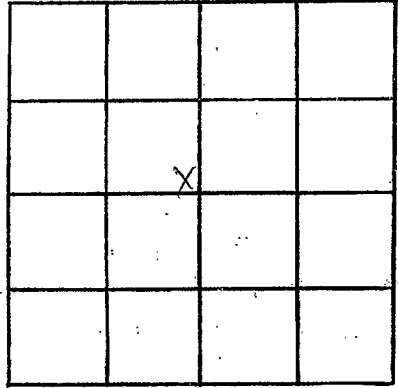

SECTION 13

Please indicate well location X.

ADDITIONAL INFORMATION

If more than one screen, show locations of each on sketch.