

MISSISSIPPI DEPARTMENT OF NATURAL RESOURCES

Bureau of Land and Water Resources

Southport Mall

P.O. Box 10631

CODED

Jackson, Mississippi 39209

WATER WELL DRILLERS LOG

M-51  
MARSHALL  
7-8-80

7-8 1980 date well completed  
Rich Well Co firm name  
Marshall county well located

LANDOWNER:  
Albertis Warren  
B. Ryhala Miss.  
(mailing address)

description of formations encountered	from	to
	Clay	0
red sand	30	90

WELL LOCATION:  
sec. 23 T 4 N R 5 E  
(3) miles N of Bayh.  
(distance) (direction) (nearest town)

white sand	90	140
CODED		

WELL PURPOSE: home  
(home, irrigation, municipal, industrial)


WELL COMPLETION DATA:  
(1) diameter (inches) 4 in  
(2) total depth (feet) 140  
(3) static water level (feet) 90 below above top of ground.  
(4) casing Plastic 140 (material) (depth)  
(size) if telescope see back.  
(5) screen 7 ft, 133 (length) (depth to top)  
4 in, Gravel (size) (material)  
(6) pump 1/2 10 (HP) (yield gpm)  
220 (type power)  
(7) electric log No (yes or no)  
(organization running log)  
(8) how well bottom plugged Cap

DRILLERS REMARKS:

DEPT. OF NATURAL RESOURCES  
BUREAU OF LAND & WATER RESOURCES  
SEP 4 - 1980  
RECEIVED

If well telescopes please sketch and show depths.

GROUND LEVEL

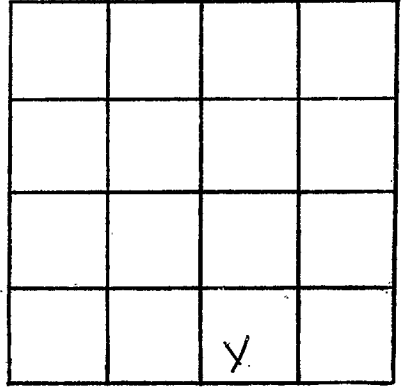

SECTION 23

Please indicate well location X.

ADDITIONAL INFORMATION

If more than one screen,  
show locations of each on sketch.