

MISSISSIPPI DEPARTMENT OF ENVIRONMENTAL QUALITY

Office of Land and Water Resources

P. O. Box 10631
Jackson, MS 39289-0631
WATER WELL DRILLERS LOG

COUNTY WELL LOCATED Marshall	
WELL NUMBER M-60	CODED
DATE WELL COMPLETED 7-21-04	

PERMIT NUMBER
NAME OF DRILLING FIRM MASSON water wells llc

NAME & MAILING ADDRESS OF LANDOWNER OAK creek village. 500 rebecca drive.
Byhalia ms 38611
Latitude: Longitude:
WELL LOCATION. SEC TOWNSHIP RANGE 14 4 N 5 E
DISTANCE DIRECTION NEAREST TOWN 4 Miles S of Watson
OTHER LANDMARK
WELL PURPOSE: Home, Irrigation, Municipal, Industrial, Fish Pond, etc.

PUMP DATA		
PUMP TYPE (Circle One): <input checked="" type="radio"/> Submersible, <input type="radio"/> Turbine, <input type="radio"/> Jet <input type="radio"/> Flowing Well, Other (Describe) _____		
POWER TYPE (Circle One): <input checked="" type="radio"/> Electric, <input type="radio"/> Tractor, <input type="radio"/> Diesel, <input type="radio"/> Gasoline, <input type="radio"/> Butane, Other (Describe) _____ H/P 3/4		

DESCRIPTION OF FORMATIONS ENCOUNTERED	FROM	TO
clay dirt.	0	15
white sand	15	45
white clay	45	60
gravel	60	85
white sand	85	170

WELL DATA		
Well Depth 170'	Casing Diameter (In.) 4"	Casing Length (Ft.) 10'
Type of Casing pvc	Hole Depth 170'	Depth to Static Water Level 60'
TYPE OF COMPLETION: (Circle One or More): <input checked="" type="radio"/> Gravel Packed, <input type="radio"/> Underreamed, <input type="radio"/> Telescoped, <input type="radio"/> Natural Development, <input type="radio"/> Open Hole, <input type="radio"/> Other (Describe) _____		
WELL GROUTED TO A DEPTH OF 10 FEET Type Grout (circle one): Cement, <input checked="" type="radio"/> Bentonite, or Mix		

SCREEN DATA		
Diameter - Inches 4	Length - Feet 15'	Slot Size - Inches #10
Screen Type pvc	Depth to Bottom - Feet 170'	

RECEIVED
AUG 02 2004
BY: OLWR
Top of Lap Pipe or Reduction in Casing
FEET IF TELESCOPED OR MORE THAN ONE SCREEN: USE BACK PAGE

I certify that the well was drilled, constructed and completed in accordance with all applicable Requirements of the Mississippi Department of Environmental Quality and/or the Mississippi Department of Health regulations and state laws.


James W. Mason 0-620
Signature of Licensed Driller and License No.

7-29-04
Date

Additional Information Required On Back

If well telescopes please sketch and show depths.

GROUND LEVEL

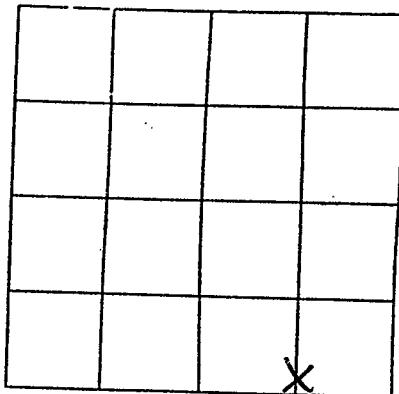

SECTION 14

Please indicate well location X.

Pump Capacity (GPM)	No. of Stages	Setting Depth
<u>12</u>	<u>11</u>	<u>100</u> FT.

PUMP TEST

Well yielded _____ GPM with
 a drawdown of _____ ft.
 after _____ hours of pumping

LOG DATA

TYPE OF LOG RUN (Circle One): No Log Run,
 Electric, Gamma Ray, Density, Sonic, Neutron,
 Other (Describe) _____

Name of Organization Running Log _____

GEOLOGIC DATA (Office Use Only)

Surface Elev.	Geologic Unit	Unit Thickness	Depth to Top
Subs. SWL	Date	Analysis	Aquifer Test

Driller's Remarks

3/4 hp - wmm-6 fiberglass bladder

If more than one screen,
 show location of each on sketch.