Remail #	$\begin{array}{c} \operatorname{Action}_{\operatorname{Construction}} \\ \operatorname{Permit \#}_{\operatorname{Construction}} \\ \\ \operatorname{Permit \#}_{\operatorname{Construction}} \\ \operatorname{Permit \#}_{\operatorname{Construction}} \\ \\ \operatorname{Permit \#}_{\operatorname{Construction}} \\ \operatorname{Permit \#}_{\operatorname{Construction}} \\ \operatorname{Permit \#}_{\operatorname{Construction}} \\ \\ \operatorname{Permit \#}_{\operatorname{Construction}} \\ \\ \operatorname{Permit \oplus}_{\operatorname{Construction}} \\ \operatorname{Permit \oplus}_{\operatorname{Construction}} \\ \\ \\ \operatorname{Permit \oplus}_{\operatorname{Construction}} \\ \\ \operatorname{Permit \oplus}_{\operatorname{Construction}} \\ \\ \\ \operatorname{Permit \oplus}_{\operatorname{Constructio}$		1	ell Report	For Office Use Only:
Permit #:	Permit#				Aquifer
Driffer Soc. S. St. M. 195(2) Date driffing completed. $5 = 13 - 02$ Jackson, MS 39289-0631 (6013961-5210 (6013961-5210 L. S. Elevation: State Law requires that this report be prepared by the license holder responsible for the work and filed with the Department at the above address within 30 days of completion of drifting of the well or borehole. L. S. Elevation: Information on Well Ower (Landowner if borehole is not for a water well) Well or Borehole Location State Law requires that this report be prepared by the license holder responsible for the work and filed with the Department at the above address within 30 days of completion of drifting of the well or borehole. Well of Borehole Location Information on Well Ower (Landowner if borehole is not for a water well) Well of Deterbole Location Dwner Name_MLE Stephenss Ariling Address: 312 fc bb cccco Big the file of the source of any surface water used for drifting: Method of Lat/Long (circle one). Conventional Survey. State Law requires and volume of Choirne used in drifting and development: MA M well / Borehole Data M State Chrone of any surface water used for drifting: MA State Chrone of any surface water used for drifting: MA Circle all applicable): M M Date drifting tand volume of Choirne used in	Driller:	Permit #:			
Date drilling completed $5-13-02$ (601)054-5210 (601)054-6938 (fax) Ls Elevator: Log #: Lo	Jack drilling completed: 5-13-0.9 Jackson, MS 39289-0051 (601)354-6938 (fax) L. S. Elevator::::::::::::::::::::::::::::::::::::	Driller: Jones w. Moson			
(601)354-6938 (fax) Eig #:	(601)354-6938 (fax) E-log #:				L. S. Elevation:
Department at the above address within 30 days of completion of drilling of the well or borehole. Information on Well Owner Information on Well Owner Well or Borehole is not for a water well) Numer Name Me Stephenss Auting Address: 310 rebbecco dive $\frac{3}{6}$ that is a mater well Stephenss Method of Latt/Long (circle one): Conventional Survey. Well Address: 310 rebbecco dive $\frac{3}{6}$ that is a 386 tl USOS quad thand-held GP, Survey-grade GPS $\frac{3}{6}$ that is a 386 tl Stephens No. (662) S64 - 3346 Date drilling completed: S-13-02 Well / Borehole Data $\frac{5}{13}$ Odd Date drilling completed: S-13-02 Aute drilling started: Image: Date drilling completed: S-13-02 Aute drilling started: Date drilling completed: S-13-02 Aute drilling started: Date drilling and development: ADA action of the source of any surface water well construction, skip the remainder of this block unpose of borehole (check one): Water Well _Geotechnical/Geological Investigation	Department at the above address within 30 days of completion of drilling of the vell or borehole. Information on Well Owner (Landowner if borehole is not for a water well) Owner NameAStephenss				E-log #:
(Landowner if borehole is not for a water well) Dwner Name $Ma \leq tephenes$ Atiling Address: 31) 1 e b b e c c o d i ver Bailing Address: 31) 1 e b b e c c o d i ver Bailing Address: 31) 1 e b b e c c o d i ver Bailing Address: 31) 1 e b b e c c o d i ver Bailing Address: 31) 1 e b b e c c o d i ver Bailing Address: 31) 1 e b b e c c o d i ver Bailing Address: 31) 1 e b b e c c o d i ver Bailing Address: 31) 1 e b b e c c o d i ver Bailing Address: 31) 1 e b b e c c o d i ver Bailing Address: 31) 1 e b b e c c o d i ver Bailing Address: 31) 1 e b b e c c o d i ver Bailing Address: 31) 1 e b b e c c o d i ver Bailing Address: 310 e b e d e d i ling completed i f b e c e d f e d i ling: 1 f e b e c c o d i ver Bail e drilling started: 1 f e b e c e d f e d f e d f e d f e d f e e e e e	$\begin{array}{c} (Landowner if borchole is not for a water well)\\ \\ \\ \\ \\ \\ \\ \\ \\ \\ \\ \\ \\ \\ \\ \\ \\ \\ \\$				
where Name Mailing Address: 317 febbecco duiting Address: Conventional Survey-grade GPS Mailing Address: 317 febbecco duiting Completed: feb feb </td <td>Owner Name Mailing Address: 317 f \in 0 b c c c c d i ve Mailing Address: 317 f \in 0 b c c c c d i ve Mailing Address: 317 f \in 0 b c c c c d i ve Mailing Address: 317 f \in 0 b c c c c d i ve Mailing Address: 317 f \in 0 b c c c c d i ve Mailing Address: 317 f \in 0 b c c c c d i ve Mailing Address: 317 f \in 0 b c c c c d i ve Mailing Address: 317 f \in 0 b c c c c d i ve Mailing Address: 317 f \in 0 b c c c c d i ve Mailing Address: 317 f \in 0 b c c c c d i ve Mailing Address: 317 f \in 0 b c c c c d i ve Mailing Address: 317 f \in 0 b c c c c d i ve Mailing Address: 317 f \in 0 b c c c c d i ve Mailing Address: 317 f \in 0 b c c c c d i ve f o c c c d ve Date drilling started: D a c rilling c ompleted: f f i 0 c d c d c d c d f i ling: MA Date drilling started: D ate drilling c o</td> <td></td> <td></td> <td>Well or Bo</td> <td>orehole Location</td>	Owner Name Mailing Address: 317 f \in 0 b c c c c d i ve Mailing Address: 317 f \in 0 b c b c c c c df i ve bithedia 32611 City State Zip Code velephone No. (662) 564-3346 Direction Nearest Town Jistance Direction nearest Town Nearest Town velephone No. (662) 564-3346 Dete drilling completed: 5-13-02 Hole depth: 170' Aute drilling started: Date drilling: DA DA ocation of the source of any surface water used for drilling: DA ocation running log(5): Date are comparization running log(5): Date drilling: DA urpose of borehole (check one): Water Well Geotechnical/Geological Investigation Ground Source Heat Pump_ Seismic Survey Other (describe) Irrigation Fish Culture Other: Inf drilling is not related to water well construction, skip the remainder of this block Irrigation Fish Culture	Mailing Address: <u>315</u> <u>fee 666ecca</u> <u>dfive</u> <u>bithalia</u> <u>Address</u> <u>Jip Code</u> Telephone No. (<u>G62</u>) <u>564-3346</u> <u>bithalia</u> <u>Jip Code</u> <u>city</u> <u>bithalia</u> <u>Jip Code</u> <u>city</u> <u>bithalia</u> <u>Jip Code</u> <u>city</u> <u>bithalia</u> <u>Jip Code</u> <u>city</u> <u>City</u> <u>Jip Code</u> <u>City</u> <u>Jip Code</u> <u>City</u> <u>City</u> <u>Jip Code</u> <u>City</u> <u>Jip Code</u> <u>J</u>			Latitude: 34 . 43 . 77	3" Longitude: 87 . 41 , 269,
dailing Address: 312 f c b b c c c c df i ve bithedia 312 f c b b c c c c df i ve bithedia 32611 City State Zip Code velephone No. (662) 564-3346 Direction Nearest Town Jistance Direction nearest Town Nearest Town velephone No. (662) 564-3346 Dete drilling completed: 5-13-02 Hole depth: 170' Aute drilling started: Date drilling: DA DA ocation of the source of any surface water used for drilling: DA ocation running log(5): Date are comparization running log(5): Date drilling: DA urpose of borehole (check one): Water Well Geotechnical/Geological Investigation Ground Source Heat Pump_ Seismic Survey Other (describe) Irrigation Fish Culture Other: Inf drilling is not related to water well construction, skip the remainder of this block Irrigation Fish Culture	Mailing Address: <u>315</u> <u>fee 666ecca</u> <u>dfive</u> <u>bithalia</u> <u>Address</u> <u>Jip Code</u> Telephone No. (<u>G62</u>) <u>564-3346</u> <u>bithalia</u> <u>Jip Code</u> <u>city</u> <u>bithalia</u> <u>Jip Code</u> <u>city</u> <u>bithalia</u> <u>Jip Code</u> <u>city</u> <u>bithalia</u> <u>Jip Code</u> <u>city</u> <u>City</u> <u>Jip Code</u> <u>City</u> <u>Jip Code</u> <u>City</u> <u>City</u> <u>Jip Code</u> <u>City</u> <u>Jip Code</u> <u>J</u>	Owner Name Mr Stephen	<u>15</u>	Hathad of Lat/Long (simple a	na): Conventional Survey
$\frac{1}{12} \frac{1}{12} \frac$	$ \underbrace{\underbrace{\underbrace{bit}_{City} & \underline{state}_{Zip}Code}_{City} \\ \underbrace{\underbrace{bit}_{City} & \underline{state}_{Zip}Code}_{Sitate} \\ \underbrace{\underbrace{bit}_{Zip}Code}_{Distrate} \\ \underbrace{\underbrace{bit}_{Sitate} & \underline{cit}_{Pi} \\ \underbrace{bit}_{Sitate} & \underline{cit}_{Pi} \\ \underbrace{bit}_{Sitate} & \underline{cit}_{Pi} \\ \underbrace{bit}_{Sitate} & \underline{cit}_{Pi} \\ \underbrace{bit}_{Sitate} & \underline{cit}_{Pi} \\ \underbrace{bit}_{Pi} \\ $	Mailing Address: 317 rebb	ecco drive		-
City State Zip Code City State Zip Code City State Zip Code Distance Direction Nearest Town 118 Miles NE of $Simple Town 118 Miles NE of Simple Town 118 Miles NE of Simple Town118 Miles NE of Simple Town 118 Miles NE of Simple Town 119 Miles NE of Simple Town 119 Miles NE of NE of Simple Town 119 Miles NE of NE of Simple Town 119 Miles NE of N$	City State Zip Code Distance IPS Miles PS of $Arrown$ Nearest fown IPS Miles IPS Nearest Near			USGS quad Hand-held	GPS, Survey-grade GPS
City State Zip Code City State Zip Code City State Zip Code Distance Direction Nearest Town 118 Miles NE of $Simple Town 118 Miles NE of Simple Town 118 Miles NE of Simple Town118 Miles NE of Simple Town 118 Miles NE of Simple Town 119 Miles NE of Simple Town 119 Miles NE of NE of Simple Town 119 Miles NE of NE of Simple Town 119 Miles NE of N$	City State Zip Code Distance IPS Miles PS of $Arrown$ Nearest fown IPS Miles IPS Nearest Near	2		NE 1/4 5 15 1/4 Sec 14	V Twn 45 Kng 5w
iclephone No. (<u>G62</u>) <u>564-3344</u> I'/& Miles <u>NE</u> of <u>GO([hi]]</u> Well / Borehole Data Date drilling started: <u>Date</u> drilling completed: <u>5-13-0</u> ? Hole depth: <u>170</u> Hole diameter: <u>6314</u> Action of the source of any surface water used for drilling: <u>MA</u> dethod of dosing and volume of Chlorine used in drilling and development: <u>AFA</u> oogs run (circle all applicable): <u>Goolog and</u> Electric Gamma Ray Density Sonie Neutron Other: iame of organization running log(s): <u>AFA</u> urpose of borehole (check one): Water Well <u>Geotechnical/Geological Investigation</u> Ground Source Heat Pump	Telephone No. (<u>669</u>) <u>564 - 3346</u> III/8 Miles <u>NE</u> of <u>COIL Mill</u> Second Control Contecontect Content Control Control Control Control Control	City City	52'611 te 7in Code	SE Distance Direction	Negrest Town
Performent SG4-334G Well / Borehole Data Date drilling started: Date drilling completed: Signature Date drilling and volume of Chlorine used in drilling and development: Area Date drilling and volume of Chlorine used in drilling and development: Area Date drilling and volume of Chlorine used in drilling and development: Area Date drilling and volume of Chlorine used in drilling and development: Area Date drilling and volume of Chlorine used in drilling and development: Area Date drilling and volume of Chlorine used in drilling and development: Area Date drilling and volume of Chlorine used in drilling and development: Area Date drilling and volume of colored describe Impose of borehole (check one): Water WellGeotechnical/Geological Investigation Ground Source Heat Pump	Telephone No. ($\underline{G_{\Theta}}$) $\underline{S_{\Theta}} \underline{4} - \underline{334G}$ Well / Borehole Data Date drilling started: $\underline{\Box}$ Date drilling completed: $\underline{5-13-0E}$ Hole depth: $\underline{150'}$ Hole diameter: $\underline{63/4}$ Location of the source of any surface water used for drilling: \underline{MA} Method of dosing and volume of Chlorine used in drilling and development: \underline{MA} . Logs run (eircle all applicable): \underline{Ma} Density Sonic Neutron Other: Name of organization running log(s): \underline{M} Purpose of borehole (check one): Water Well $\underline{\Box}$ Geotechnical/Geological Investigation Ground Source Heat Pump Seismic SurveyOther (describe) If drilling is not related to water well construction, skip the remainder of this black Purpose of Well (check one): Home $\underline{\Box}$ Industrial Public Supply Irrigation Fish CultureOther:	· ·	-	118 Miles NE	of Woll hill
Date drilling started: $\begin{tabular}{ c c c c c c c c c c c c c c c c c c c$	Date drilling started:	Telephone No. (662) 564 - 36	<u>ч</u> (<u></u>		
Date drilling started: Date drilling completed: \$\$\frac{5}{3}-0\nothermole P\$ Hole depth: 1\00' Hole diameter: \$\$\frac{3}{4}\$ Acthod of dosing and volume of Chlorine used in drilling: NA Acthod of dosing and volume of Chlorine used in drilling: NA Acthod of dosing and volume of Chlorine used in drilling: NA Acthod of dosing and volume of Chlorine used in drilling: NA Acthod of dosing and volume of Chlorine used in drilling: NA Acthod of dosing and volume of Chlorine used in drilling: NA Acthod of dosing and volume of Chlorine used in drilling: NA Acthod of dosing and volume of Chlorine used in drilling: NA Acthod of dosing and volume of Chlorine used in drilling: NA Acthod of organization running log(s):	Date drilling started: Image: Date drilling completed: \$\overline{1} - 3 - 0 - 0^{\overline{2}}\$ Hole depth: 1 - 20^{-1}\$ Hole diameter: 6 - 31/4 Location of the source of any surface water used for drilling:	-12-0A	Well / Bore	nole Data	
coation of the source of any surface water used for drilling:	Location of the source of any surface water used for drilling:		illing completed: 5-13-0	SE Hole depth: (70'	Hole diameter: 63/4
Atthod of dosing and volume of Chlorine used in drilling and development:	Method of dosing and volume of Chlorine used in drilling and development:				
Logs run (circle all applicable): Use Gamma Ray Density Sonic Neutron Other: urpose of borehole (check one): Water WellGeotechnical/Geological Investigation Ground Source Heat Pump	Logs run (circle all applicable): Circle one) adder wellGeotechnical/Geological InvestigationGround Source Heat Pump				
tame of organization running log(s):	Name of organization running log(s):			·	
Seismic SurveyOther (describe)	Seismic Survey_Other (describe) If drilling is not related to water well construction, skip the remainder of this block Purpose of Well (check one): Home Industrial Public Supply_ Irrigation_ Fish Culture _Other:			Density Sonic Neutron	Other:
If drilling is not related to water well construction, skip the remainder of this block turpose of Well (check one): HomeIndustrial Public Supply Irrigation Fish CultureOther: Other:Other: f a flowing well, method of flow regulation: Valve Other (describe) Other: tatic Water Level: & feet above or below (circle one) land surface Date measured: 5 - ∂ 7 - C ? tatic Water Level: & feet above or below (circle one) land surface Date measured: 5 - ∂ 7 - C ? tatic Water Level: & feet above or below (circle one) land surface Date measured:	If drilling is not related to water well construction, skip the remainder of this block Purpose of Well (check one): HomeIndustrial Public Supply Irrigation Fish CultureOther: Other (describe)	Purpose of borehole (check one): Water W	ell Geotechnical/Geolo	gical Investigation Ground	Source Heat Pump
If drilling is not related to water well construction, skip the remainder of this block turpose of Well (check one): HomeIndustrial Public Supply Irrigation Fish CultureOther: Other:Other: f a flowing well, method of flow regulation: Valve Other (describe) Other: tatic Water Level: & feet above or below (circle one) land surface Date measured: 5 - ∂ 7 - C ? tatic Water Level: & feet above or below (circle one) land surface Date measured: 5 - ∂ 7 - C ? tatic Water Level: & feet above or below (circle one) land surface Date measured:	If drilling is not related to water well construction, skip the remainder of this block Purpose of Well (check one): HomeIndustrial Public Supply Irrigation Fish CultureOther: Other (describe)	Seismic	Survey Other (<i>describe</i>)		
f a flowing well, method of flow regulation: Valve Other (describe) tatic Water Level: & feet above or below (Grcle one) land surface Date measured: 5 - ∂7 - C.E Method of Measurement (circle one) steel tape electric tape air line other: <u>string loweight</u> Vell depth: <u>170</u> Well grouted to a depth of <u>10</u> feet Type of grout (circle one): Neat Cement Bentonite Mix casing length: <u>160</u> feet Casing diameter: <u>4</u> inches Type of casing: <u>proc</u> creen length: <u>(0)</u> feet Screen diameter: <u>4</u> inches Type of screen: <u>proc</u> creen slot size: <u>010</u> inches Setting depth: From <u>1600</u> feet to <u>(700)</u> feet type of completion (circle all applicable): Gravel packed Underreamed Telescoped Open hole Natural Development Other (describe): <u>A</u> for of lap pipe or reduction in casing: <u>MA</u> feet. If telescoped or more than one screen, describe on next page Form: OLWR-SWR-1A	If a flowing well, method of flow regulation: Valve <u>M</u> Other (describe) Static Water Level: <u>80</u> feet above or below (circle one) land surface Date measured: <u>5 - 27 - 08</u> Method of Measurement (circle one) steel tape electric tape air line other: <u>5 + 27 - 08</u> Well depth: <u>170</u> Well grouted to a depth of <u>10</u> feet Type of grout (circle one): Neat Cement Bentonite Mix Casing length: <u>160</u> feet Casing diameter: <u>4</u> inches Type of casing: <u>945</u> Screen length: <u>0</u> feet Screen diameter: <u>4</u> inches Type of screen: <u>945</u> Screen slot size: <u>010</u> inches Setting depth: From <u>1600</u> feet to <u>170</u> feet Type of completion (circle all applicable): Gravel packed Underreamed Telescoped Open hole Natural Development Other (describe): <u>A</u> Form: Other (describe): <u>A</u> Form: Other. <u>1600</u> feet. <u>If telescoped or more than one screen, describe on next page</u>				ock
tatic Water Level: <u>80</u> feet above or below (Grcle one) land surface Date measured: <u>5.37.08</u> Method of Measurement (circle one) steel tape electric tape air line other: <u>string loveright</u> Vell depth: <u>170</u> Well grouted to a depth of <u>10</u> feet Type of grout (circle one): Neat Cement Bentonite Mix Casing length: <u>160</u> feet Casing diameter: <u>4</u> inches Type of casing: <u>proc</u> creen length: <u>100</u> feet Screen diameter: <u>4</u> inches Type of screen: <u>proc</u> creen slot size: <u>010</u> inches Setting depth: From <u>1600</u> feet to <u>170</u> feet type of completion (circle all applicable): Gravel packed Underreamed Telescoped Open hole Natural Development Other (describe): <u>A</u> top of lap pipe or reduction in casing: <u>NA</u> feet. If telescoped or more than one screen, describe on next page Form: OLWR-SWR-1A	Static Water Level: <u>80</u> feet above or below (circle one) land surface Date measured: <u>5 - 37 - 0.8</u> Method of Measurement (circle one) steel tape electric tape air line other: <u>string lovelight</u> Well depth: <u>170</u> Well grouted to a depth of <u>10</u> feet Type of grout (circle one): Neat Cement Bentonite Mix Casing length: <u>160</u> feet Casing diameter: <u>4</u> inches Type of casing: <u>94</u> Screen length: <u>100</u> feet Screen diameter: <u>4</u> inches Type of screen: <u>94</u> Screen slot size: <u>010</u> inches Setting depth: From <u>160</u> feet to <u>170</u> feet Type of completion (circle all applicable): Gravel packed Underreamed Telescoped Open hole Natural Development Other (describe): <u>94</u> Top of lap pipe or reduction in casing: <u>MA</u> feet. <u>If telescoped or more than one screen, describe on next page</u> Form: OLWR-SWR-1 REECEL	Purpose of Well (check one): Home <u>1</u>	ndustrial Public Supply	Irrigation Fish Culture	Other:
Method of Measurement (circle one) steel tape electric tape air line other: string <a a="" href="string" string<=""> <a href="string" string"string"string"string"string"string"st<="" td=""><td>Method of Measurement (circle one) steel tape electric tape air line other: <u>String Luveight</u> Well depth: <u>170</u> Well grouted to a depth of <u>10</u> feet Type of grout (circle one): Neat Cement Bentonite Mix Casing length: <u>160</u> feet Casing diameter: <u>4</u> inches Type of casing: <u>puc</u> Screen length: <u>60</u> feet Screen diameter: <u>4</u> inches Type of screen: <u>puc</u> Screen slot size: <u>610</u> inches Setting depth: From <u>160</u> feet to <u>600</u> feet Type of completion (circle all applicable): Gravel packed Underreamed Telescoped Open hole Natural Development Other (describe): <u>600</u> feet. <u>If telescoped or more than one screen, describe on next page</u> Form: OLWR-SWR-1 RECCEN</td><td>If a flowing well, method of flow regulation</td><td>n: Valve Ot</td><td>her (describe)</td><td></td>	Method of Measurement (circle one) steel tape electric tape air line other: <u>String Luveight</u> Well depth: <u>170</u> Well grouted to a depth of <u>10</u> feet Type of grout (circle one): Neat Cement Bentonite Mix Casing length: <u>160</u> feet Casing diameter: <u>4</u> inches Type of casing: <u>puc</u> Screen length: <u>60</u> feet Screen diameter: <u>4</u> inches Type of screen: <u>puc</u> Screen slot size: <u>610</u> inches Setting depth: From <u>160</u> feet to <u>600</u> feet Type of completion (circle all applicable): Gravel packed Underreamed Telescoped Open hole Natural Development Other (describe): <u>600</u> feet. <u>If telescoped or more than one screen, describe on next page</u> Form: OLWR-SWR-1 RECCEN	If a flowing well, method of flow regulation	n: Valve Ot	her (describe)	
Method of Measurement (circle one) steel tape electric tape air line other: string <a a="" href="string" string<=""> <a href="string" string"string"string"string"string"string"st<="" td=""><td>Method of Measurement (circle one) steel tape electric tape air line other: <u>String Luveight</u> Well depth: <u>170</u> Well grouted to a depth of <u>10</u> feet Type of grout (circle one): Neat Cement Bentonite Mix Casing length: <u>160</u> feet Casing diameter: <u>4</u> inches Type of casing: <u>puc</u> Screen length: <u>60</u> feet Screen diameter: <u>4</u> inches Type of screen: <u>puc</u> Screen slot size: <u>610</u> inches Setting depth: From <u>160</u> feet to <u>600</u> feet Type of completion (circle all applicable): Gravel packed Underreamed Telescoped Open hole Natural Development Other (describe): <u>600</u> feet. <u>If telescoped or more than one screen, describe on next page</u> Form: OLWR-SWR-1 RECCEN</td><td>Static Water Level: 80 feet al</td><td>ove or below (circle one) la</td><td>ind surface Date measured:</td><td>5-27-08</td>	Method of Measurement (circle one) steel tape electric tape air line other: <u>String Luveight</u> Well depth: <u>170</u> Well grouted to a depth of <u>10</u> feet Type of grout (circle one): Neat Cement Bentonite Mix Casing length: <u>160</u> feet Casing diameter: <u>4</u> inches Type of casing: <u>puc</u> Screen length: <u>60</u> feet Screen diameter: <u>4</u> inches Type of screen: <u>puc</u> Screen slot size: <u>610</u> inches Setting depth: From <u>160</u> feet to <u>600</u> feet Type of completion (circle all applicable): Gravel packed Underreamed Telescoped Open hole Natural Development Other (describe): <u>600</u> feet. <u>If telescoped or more than one screen, describe on next page</u> Form: OLWR-SWR-1 RECCEN	Static Water Level: 80 feet al	ove or below (circle one) la	ind surface Date measured:	5-27-08
Vell depth: 170 Well grouted to a depth of 10 feet Type of grout (circle one): Neat Cement Bentonite Mix Casing length: 160 feet Casing diameter: 4 inches Type of casing: 5 Image: 5 creen length: 0 feet Screen diameter: 4 inches Type of screen: 5 Image: 5 Image: 5 creen slot size: 0 0 feet Screen diameter: 4 inches Type of screen: 5 Image:	Well depth: 170 Well grouted to a depth ofO feet Type of grout (circle one): Neat Cement Bentonite Mix Casing length: O_O feet Casing diameter:				
creen length: <u>(0</u> feet Screen diameter: <u>4</u> inches Type of screen: <u>poi</u> creen slot size: <u>, 010</u> inches Setting depth: From <u>1600</u> feet to <u>170</u> feet type of completion (circle all applicable): Gravel packed Underreamed Telescoped Open hole Natural Development Other (describe): <u>A</u> top of lap pipe or reduction in casing: <u>NA</u> feet. <u>If telescoped or more than one screen, describe on next page</u> Form: OLWR-SWR-1A	Screen length:				
creen slot size: inches Setting depth: From feet to feet to feet gype of completion (circle all applicable): Gravel packed Underreamed Telescoped Open hole Natural Development Other (describe): fop of lap pipe or reduction in casing: feet. If telescoped or more than one screen, describe on next page Form: OLWR-SWR-1A	Screen slot size:OLOinches Setting depth: FromLGOfeet toLOOfeet Type of completion (circle all applicable): Gravel packed Underreamed Telescoped Open hole Natural Development Other (describe):A Top of lap pipe or reduction in casing:A feet. If telescoped or more than one screen, describe on next page Form: OLWR-SWR-1 RECEI				
creen slot size: inches Setting depth: From feet to feet to feet gype of completion (circle all applicable): Gravel packed Underreamed Telescoped Open hole Natural Development Other (describe): fop of lap pipe or reduction in casing: feet. If telescoped or more than one screen, describe on next page Form: OLWR-SWR-1A	Screen slot size:OLOinches Setting depth: FromLGOfeet toLOOfeet Type of completion (circle all applicable): Gravel packed Underreamed Telescoped Open hole Natural Development Other (describe):A Top of lap pipe or reduction in casing:A feet. If telescoped or more than one screen, describe on next page Form: OLWR-SWR-1 RECEI				
Other (describe):	Other (describe):				
op of lap pipe or reduction in casing: <u><i>NA</i></u> feet. <u>If telescoped or more than one screen, describe on next page</u> Form: OLWR-SWR-1A	Fop of lap pipe or reduction in casing: <u>NA</u> feet. <u>If telescoped or more than one screen, describe on next page</u> Form: OLWR-SWR-1 RECEI	Type of completion (circle all applicable):	Gravel packed Underr	eamed Telescoped Open	hole Natural Development
Form: OLWR-SWR-1A	Form: OLWR-SWR-1		Other (describe):	nA	
	RECEI	Top of lap pipe or reduction in casing:	NA feet. If tele	escoped or more than one scree	en, describe on next page
RECEIV				······································	
					RECEIV

٦.

.

JUN 2 5 2008 BY: OLWP

M- 82

The sketch below only required for water wells


If well telescopes, show depths on sketch.

Ground Level

<u>Description of formations encountered must be provided for all</u> wells and boreholes, unless specifically exempted by regulations

Description of Formations Encountered	From (depth)	To (depth)
clay dirt.	Ground Level	10
Icd Soud	10	35
grove (35	40
while charl	40	03
white source	03	170
		ļ
	•	
		l

If more than one screen, show location of each on sketch

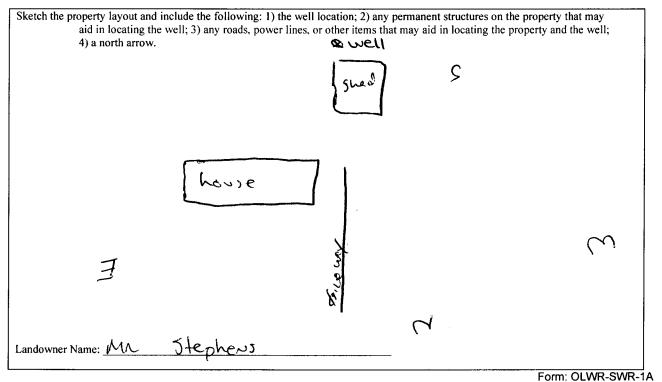

I certify that the well/borehole was drilled, constructed, and completed in accordance with all applicable requirements of the Mississippi Department of Environmental Quality and the Mississippi Department of Health regulations, if applicable, and state

Date

laws W. Mosen 0-620 6-10 08 10 mer

Print Name of Responsible Licensee and License No.

Signature of Licensee

JUN 2 5 2008

RECEIVED

BY: OLWP

	STATE WELL REPORT	
County: Marshall	Part 2 Pump Installer's Completion Report	For Office Use Only:
Permit #:	Mississippi Department of Environmental Quality	Aquifer:
Driller: Jones W. Mosco	Office of Land and Water Resources P.O. Box 10631	11.81
Date completed: 5-37-08	Jackson, MS 39289-0631 (601)961-5210	Well #: <u>M-82</u>
Copy information from block on Part 1	(601)961-3210 (601)354-6938 (fax)	Elevation:

This part of the report must be completed by a licensed water well contractor or a licensed pump installer. A copy of Part 1 of the report must be attached and both parts filed with the Department at the above address within 30 days of well completion.
Well Owner Information
Well Location

wen Owner Information	wen Location
Owner Name: MA Stephens	Latitude: 34.43.773 Longitude: 85.41.269
Mailing Address: 317 rebbecce drive	Method of Lat/Long (check one): Conventional Survey,
	USGS quad, Hand-held GPS, Survey-grade GPS
Byhalic Ms 32611 City State Zip Code	USGS quad, Hand-held GPS, Survey-grade GPS NE 14_SE 14 Sec_14_T_4s_R_5w
	Distance Direction Nearest Town
Telephone No. (662) 564 - 3246	11/8 Miles NE of Woll Will

	Pump Type Circle one			Power Type Circle one	
Air Lift	Jet (Submersible	Diesel Engine	Gasoline Engine	Natural Gas
Bucket	Piston	Turbine	Electric Motor	Hand	Tractor PTO
Centrifugal	Rotary	Flowing Well	Windmill	Other (specify):	
Other (specify):			Horse Power Rating of	of Motor: 3/ 1	
Date Pump Installed:	5-27-08		Setting Depth:	(00	feet
Rated Pump Capacity:	(0)	_Gallons Per Minute	Number of Stages:	8	_

Pump Test Data	Method of Measuring Water Level		
Date Well Tested: $5 - \partial 7 - \delta \delta$	Circle one		
_	Air Line Electric Measuring Line Steel Tape		
Static Water Level (A):Feet Below Land Surface	Other (specify): String I meight		
Pumping Water Level (B): <u>NA</u> Feet Below Land Surface	onier (specify). <u>> (778) 13(21)</u>		
Drawdown [(B) – (A)]:Feet Below Land Surface	For flowing well, measured shut in head:feet		
Test Pumping Rate: (O Gallons Per Minute	Well yielded $\ell \circ$ GPM with a drawdown of		
Duration of Pump Test (minimum 4 hours): <u>24</u> hours	$\underline{\mathcal{NA}}$ feet after $\underline{\mathcal{P}Y}$ hours of pumping		

I HEREBY CERTIFY that the above statements are true to the best	of my knowledge.	
Jone, W. Mosor 0-620	Gons i. Man	
Print Name of Pump Installer and License No. (if applicable)	Signature of Pump Installer	DEOENT
	Fo	

JUN 2 5 2008 BY: OLWP