

Marshall
M 2000
12-31-75

MISSISSIPPI
BOARD OF WATER COMMISSIONERS
416 North State Street
Jackson, Mississippi 39201

WATER WELL DRILLERS LOG

12-31-1975 date well completed
HICKS well co firm name
MARSHALL county well located

LANDOWNER: FRANK CARTER
MEMPHIS TENN
(mailing address)


description of formations encountered	from	to
Red clay	0	10
Red sand & clay	10	20
White clay & sand	20	118
White sand	118	140

WELL LOCATION:
sec. 14 T. 4 N R. 5 E
16 miles East of Caldwell
(distance) (direction) (nearest town)

WELL PURPOSE: House
(home, irrigation, municipal, industrial)

- WELL COMPLETION DATA:
- (1) diameter (inches) 4"
 - (2) total depth (feet) 140'
 - (3) static water level (feet) 60 below above top of ground.
 - (4) casing PVC, 13.3'
(material) (depth)
(size) If telescope see back.
 - (5) screen 7', 7'
(length) (depth to top)
4", Gravel type
(size) (material)
 - (6) pump 1/2, 10
(HP) (yield gpm)
500 Elec.
(type power)
 - (7) electric lqg NO
(yes or no)
(organization running log)
 - (8) how well bottom plugged C2P


DRILLERS REMARKS:

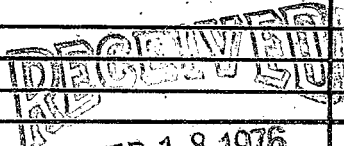

MISS. Bd. OF WATER COMMISSIONERS

If well telescopes please sketch and show depths.

GROUND LEVEL

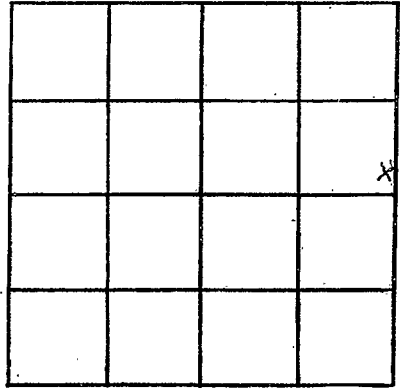

SECTION 14

Please indicate well location X.

ADDITIONAL INFORMATION

If more than one screen, show locations of each on sketch.