

Marshall  
M 2001  
1-5-76

MISSISSIPPI  
 BOARD OF WATER COMMISSIONERS  
 416 North State Street  
 Jackson, Mississippi 39201

WATER WELL DRILLERS LOG


1-5 1976 Hicks Well Co. Marshall  
 date well completed firm name county well located

LANDOWNER: <u>FRANK Lewis</u>	description of formations encountered	from	to
<u>RT-3 coldwater miss</u>	<u>Red clay</u>	<u>0</u>	<u>10</u>
(mailing address)	<u>7. sand</u>	<u>10</u>	<u>20</u>
WELL LOCATION:	<u>White clay &amp; sand</u>	<u>20</u>	<u>140</u>
sec. <u>14</u> T- <u>4</u> N R- <u>5</u> E	<u>White sand</u>	<u>140</u>	<u>18.5</u>
<u>16</u> miles <u>EAST</u> of <u>Coldwater</u>			
(distance) (direction) (nearest town)			
WELL PURPOSE: <u>Home</u>			
(home, irrigation, municipal, industrial)			
WELL COMPLETION DATA:			
(1) diameter (inches) <u>4"</u>			
(2) total depth (feet) <u>185</u>			
(3) static water level (feet) <u>10</u> below above top of ground.			
(4) casing <u>PVC</u> , <u>178</u>			
(size) (material) (depth)			
_____ if telescope see back.			
(5) screen <u>7'</u> , <u>7'</u>			
(length) (depth to top)			
<u>4"</u> , <u>inside sand</u>			
(size) (material)			
(6) pump <u>10</u> , <u>10</u>			
(HP) (yield gpm)			
<u>2.20</u> <u>EIC</u>			
(type power)			
(7) electric log _____			
(yes or no)			
(organization running log)			
(8) how well bottom plugged <u>CAP</u>			
DRILLERS REMARKS:			

RECEIVED  
 FEB 18 1976

If well telescopes please sketch and show depths.

GROUND LEVEL

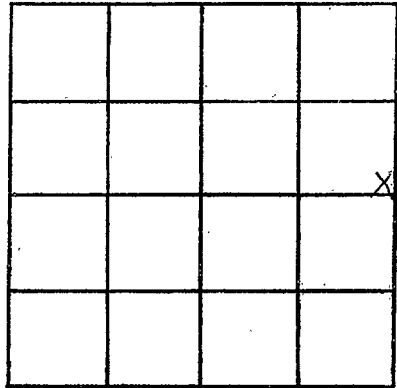

SECTION 14

Please indicate well location X.

ADDITIONAL INFORMATION

If more than one screen,  
show locations of each on sketch.