

MARSHALL
 M 2003
 3-23-76

MISSISSIPPI
 BOARD OF WATER COMMISSIONERS
 416 North State Street
 Jackson, Mississippi 39201

WATER WELL DRILLERS LOG

3-23 1976 *Hicks well co.* *Marshall*
 date well completed firm name county well located

LANDOWNER: *Mark Finley*
 RT-2
 Coldwater, Missc
 (mailing address)

description of formations encountered	from	to
<i>Red clay</i>	<i>0</i>	<i>10</i>
<i>RS</i>	<i>10</i>	<i>20</i>
<i>Coarse SAND</i>	<i>20</i>	<i>60</i>
<i>SAND + CLAY</i>	<i>60</i>	<i>140</i>
<i>W.S.</i>	<i>140</i>	<i>197</i>

WELL LOCATION:
 sec. *14* T *4* N R *5* E
 S W
16 miles *E* of *Coldwater*
 (distance) (direction) (nearest town)

WELL PURPOSE: *HOME*
 (home, irrigation, municipal, industrial)


- WELL COMPLETION DATA:
- (1) diameter (inches) *4"*
 - (2) total depth (feet) *177*
 - (3) static water level (feet) *80* below above top of ground.
 - (4) casing *PVC*, *170*,
 (material) (depth)
 (size) if telescope see back.
 - (5) screen *7'* ~~*7'*~~
 (length) (depth to top)
4", *Inside gravel*
 (size) (material)
 - (6) pump *1/2* *10*
 (HP) (yield gpm)
220
 (type power)
 - (7) electric log (yes or no)
 - (organization running log)
 - (8) how well bottom plugged *CAP*

DRILLERS REMARKS:

APR 20 1976
 MISS. BUREAU OF WATER CONTROL

If well telescopes please sketch and show depths.

GROUND LEVEL

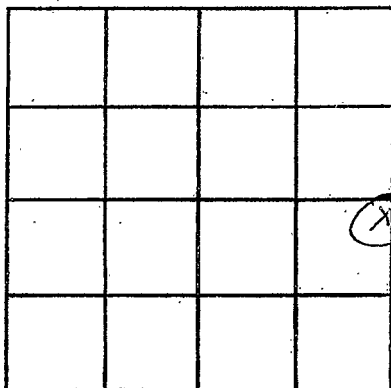

SECTION _____

Please indicate well location X.

ADDITIONAL INFORMATION

If more than one screen,
show locations of each on sketch.