

Marshall
 M 2004
 5-20-76

MISSISSIPPI
 BOARD OF WATER COMMISSIONERS
 416 North State Street
 Jackson, Mississippi 39201

WATER WELL DRILLERS LOG

5-20-1976 ^{W.A. Mason} Waterwell Contractors ^{Marshall} Marshall
 date well completed firm name county well located

LANDOWNER:
 Roy Stevens
 RFD - Byhalia Miss
 (mailing address)

WELL LOCATION:
 sec 26 T 4 N R 5 E
 1/2 miles South, Wall Hill
 (distance) (direction) (nearest town)

WELL PURPOSE: RESORT
 (home, irrigation, municipal, industrial)

WELL COMPLETION DATA:
 (1) diameter (inches) 4"
 (2) total depth (feet) 165'
 (3) static water level (feet) 90' below top of ground.
 (4) casing Pvc Plastic 145' (material) (depth) 4" (size) If telescope see back.
 (5) screen 20' 145' (length) (depth to top) 4" Pvc Plastic (size) (material)
 (6) pump 3/4 15 (HP) (yield gpm)
 electric (type power)
 (7) electric log NO (yes or no)

| description of formations encountered | from | to |
|---------------------------------------|------|-----|
| Clay Fert | 0 | 8 |
| red clay | 8 | 20 |
| red sand | 20 | 27 |
| red clay | 27 | 60 |
| white clay | 60 | 76 |
| white sand | 76 | 165 |


DRILLERS REMARKS:
 Cap on screen

RECEIVED

JUN 28 1976

If well telescopes please sketch and show depths.

GROUND LEVEL

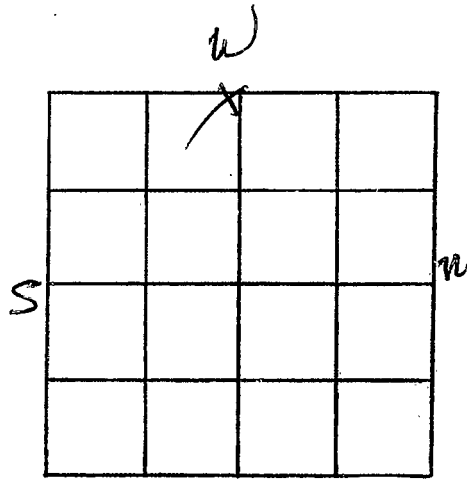

SECTION 26

Please indicate well location X.

ADDITIONAL INFORMATION

If more than one screen,
show locations of each on sketch.