

MARSHALL
 M 2006
 6-25-76

MISSISSIPPI
 BOARD OF WATER COMMISSIONERS
 416 North State Street
 Jackson, Mississippi 39201


WATER WELL DRILLERS LOG

6-25 1976 ^{15E} *Hicks Well Co.* *Marshall*
 date well completed firm name county well located

LANDOWNER: <i>John Shaw</i> <i>Rt. 3</i>	description of formations encountered	from	to
<i>Byhalis, Miss</i> (mailing address)	<i>Red Sand & Clay</i>	<i>0</i>	<i>60</i>
WELL LOCATION: sec. <i>25</i> T <i>4</i> N R <i>5</i> E <i>20</i> miles <i>E</i> of <i>Coldwater</i> (distance) (direction) (nearest town)	<i>White Clay & Sand</i>	<i>60</i>	<i>140</i>
WELL PURPOSE: <i>Home</i> (home, irrigation, municipal, industrial)	<i>White Sand</i>	<i>140</i>	<i>170</i>
WELL COMPLETION DATA: (1) diameter (inches) <i>4"</i> (2) total depth (feet) <i>170</i> (3) static water level (feet) <i>80</i> below above top of ground. (4) casing <i>PVC</i> , <i>170</i> , (material) (depth) ____ (size) if telescope see back. (5) screen <i>4'</i> , <i>166</i> (length) (depth to top) <i>4"</i> , <i>Gravel</i> (size) (material) (6) pump <i>1/2</i> , <i>10</i> (HP) (yield gpm) <i>220</i> (type power) (7) electric log <i>NO</i> (yes or no) ____ (organization running log) (8) how well bottom plugged <i>Gravel</i> <i>Sand</i>			
DRILLERS REMARKS:			

If well telescopes please sketch and show depths.

GROUND LEVEL

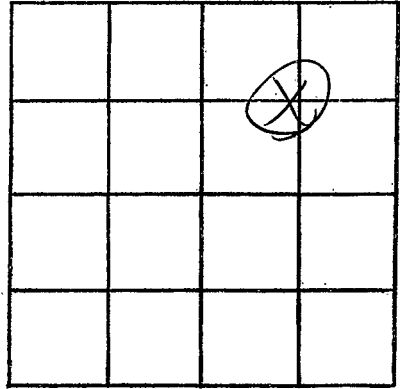

SECTION 25

Please indicate well location X.

ADDITIONAL INFORMATION

If more than one screen,
show locations of each on sketch.