

These people need help in being able to locate wells

MISSISSIPPI BOARD OF WATER COMMISSIONERS on Map.  
 416 North State Street  
 Jackson, Mississippi 39201

Also they don't even put date

Marshall  
 M 2007  
 3/1/77

WATER WELL DRILLERS LOG

Atkinson & Frost Marshall

19 date well completed firm name county well located

LANDOWNER: Connie B. BOGAN  
 Box 194 Byhalia Miss  
 (mailing address)

description of formations encountered	from	to
Clay	0	15
sand	15	30
Clay	30	35
white sand	35	100

WELL LOCATION:  
 sec. 3 T 4 N R 5 E if 2 mi from Watson  
 2 miles SW of Watson  
 (distance) (direction) (nearest town)

WELL PURPOSE: home  
 (home, irrigation, municipal, industrial)

- WELL COMPLETION DATA:
- (1) diameter (inches) 4"
  - (2) total depth (feet) 100'
  - (3) static water level (feet) 35' below top of ground.
  - (4) casing PVC, 100' (material) (depth)
  - (size) if telescope see back.
  - (5) screen 10' (length) 90' (depth to top)
  - 4" PVC (size) (material)
  - (6) pump 3/4 (HP) 15 (yield gpm)
  - Elec. (type power)
  - (7) electric log NO (yes or no)

(organization running log)

(8) how well bottom plugged CAP

RECEIVED


MAR 28 1977

DRILLERS REMARKS:

MISS. BOARD OF WATER COMMISSIONERS

If well telescopes please sketch and show depths.

GROUND LEVEL

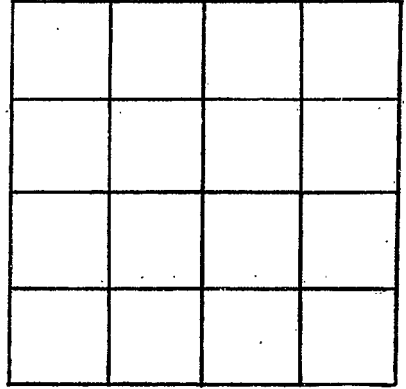

SECTION \_\_\_\_\_

Please indicate well location X.

ADDITIONAL INFORMATION

If more than one screen,  
show locations of each on sketch.