

MARSHALL  
M 2008  
6/28/76

MISSISSIPPI  
BOARD OF WATER COMMISSIONERS  
416 North State Street  
15E Jackson, Mississippi 39201

WATER WELL DRILLERS LOG

6-28 date well completed  
1976 W.C. Mason firm name  
Waterford Marshall county well located

LANDOWNER:  
Mrs. L. B. Gilles  
Rt. 3, Byhalia Miss.  
(mailing address)

description of formations encountered	from	to
Clay Det	0	8
gravel	8	40

WELL LOCATION:  
sec. 26 T 4 N R 5 E  
1/4 miles east of Marshall  
(distance) (direction) (nearest town)

white sand	40	132
------------	----	-----

WELL PURPOSE: drinking  
(home, irrigation, municipal, industrial)

- WELL COMPLETION DATA:
- (1) diameter (inches) 4"
  - (2) total depth (feet) 132'
  - (3) static water level (feet) 62' below top of ground
  - (4) casing Plastic, 122' (material) (depth)  
4" (size) if telescope see back.
  - (5) screen 10', 122' (length) (depth to top)  
4" (size) Plastic (material)
  - (6) pump 3/4 (HP) 10 (yield gpm)  
electric (type power)
  - (7) electric log NO (yes or no)

(organization running log)  
(8) how well bottom plugged cap


DRILLERS REMARKS:

RECEIVED  
JUL 7 1976

MISS. BD. OF WATER COM.

If well telescopes please sketch and show depths.

GROUND LEVEL

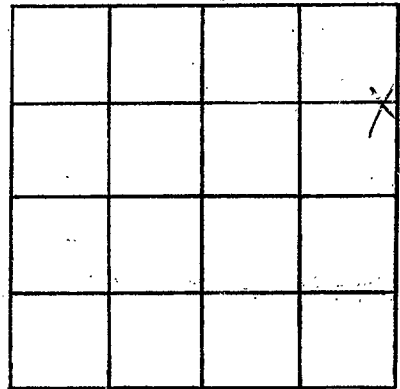

SECTION 26

Please indicate well location X.

ADDITIONAL INFORMATION

If more than one screen, show locations of each on sketch.