

Marshall
M 2009
5-19-77

MISSISSIPPI
 BOARD OF WATER COMMISSIONERS
 416 North State Street
 Jackson, Mississippi 39201

WATER WELL DRILLERS LOG

5-19 1977 Hicks Well Co. Marshall
 date well completed firm name county well located


LANDOWNER: <u>Jamert. Robinson</u>	description of fomations encountered	from	to
<u>Box 3</u> <u>Coldwater, Ms.</u> (mailing address)			
WELL LOCATION: sec. <u>23</u> T <u>4</u> N R <u>5</u> E <u>1</u> miles <u>N</u> of <u>Wall Hill</u> (distance) (direction) (nearest town)	<u>Red Clay</u>	<u>0</u>	<u>40</u>
WELL PURPOSE: <u>Home</u> (home, irrigation, municipal, industrial)	<u>White Sand & Clay</u>	<u>40</u>	<u>120</u>
WELL COMPLETION DATA: (1) diameter (inches) <u>4</u> (2) total depth (feet) <u>145</u> (3) static water level (feet) <u>25</u> below above top of ground. (4) casing <u>PVC</u> , <u>145</u> , (material) (depth) (size) if telescope see back. (5) screen <u>7'</u> , <u>138</u> (length) (depth to top) <u>4"</u> , <u>gravel type</u> (size) (material) (6) pump <u>1/2</u> , <u>10</u> (HP) (yield gpm) <u>2200</u> (type power) (7) electric log <u>No</u> (yes or no) (organization running log) (8) how well bottom plugged <u>Cap</u>	<u>White Sand</u>	<u>120</u>	<u>145</u>
DRILLERS REMARKS:			

RECEIVED
 JUL 13 1977

MISS. BD. OF WATER COMMISSIONERS

If well telescopes please sketch and show depths.

GROUND LEVEL

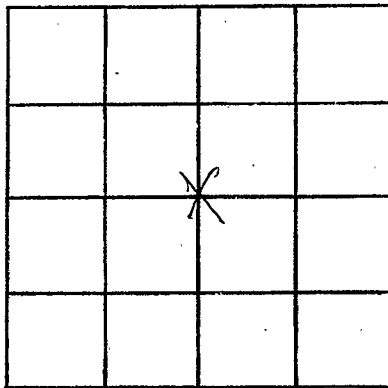

SECTION 23

Please indicate well location X.

ADDITIONAL INFORMATION

If more than one screen,
show locations of each on sketch.