

MARSHALL  
M 2010  
5-19-77

MISSISSIPPI  
BOARD OF WATER COMMISSIONERS  
416 North State Street  
Jackson, Mississippi 39201

WATER WELL DRILLERS LOG

5-19-1977 date well completed  
Hick Wall Co. firm name  
Marshall county well located

LANDOWNER: Charles Fogg  
Pt. 3  
Coldwater, Ms.  
(mailing address)

description of formations encountered	from	to
Red clay	0	20
Red Sand & clay	20	40
White Sand	40	100
White clay	100	120
White Sand	120	145

WELL LOCATION:  
sec. 23 T 4 N R 5 E  
1 miles N of Wall Hill  
(distance) (direction) (nearest town)

WELL PURPOSE: Home  
(home, irrigation, municipal, industrial)

- WELL COMPLETION DATA:
- (1) diameter (inches) 4
  - (2) total depth (feet) 145
  - (3) static water level (feet) 75 below above top of ground.
  - (4) casing PVC, 145, (material) (depth) (size) if telescope see back.
  - (5) screen 7, 138, (length) (depth to top) 4" gravel type, (size) (material)
  - (6) pump 1/2, 10, (HP) (yield gpm) 220V (type power)
  - (7) electric log No (yes or no)
  - (organization running log)
  - (8) how well bottom plugged Cap


DRILLERS REMARKS:

RECEIVED  
JUL 13 1977

MISS. BD. OF WATER COMMISSIONERS

If well telescopes please sketch and show depths.

GROUND LEVEL

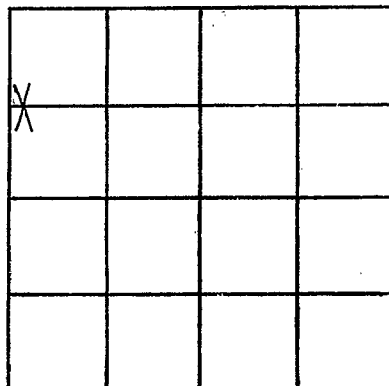

SECTION 23

Please indicate well location X.

ADDITIONAL INFORMATION

If more than one screen,  
show locations of each on sketch.