

MARSHALL

M 2012

5-29-78

MISSISSIPPI BOARD OF WATER COMMISSIONERS
416 North State Street
Jackson, Mississippi 39201

WATER WELL DRILLERS LOG

5-29 1978 High Well Co Marshall
date well completed firm name county well located

| LANDOWNER: <u>Willie Maye</u> <u>Box 3</u> | description of formations encountered | from | to |
|--|---------------------------------------|-----------|------------|
| <u>Begonia, Mo.</u> (mailing address) | | | |
| WELL LOCATION: sec. <u>11</u> T. <u>4</u> N. <u>5</u> R. <u>2</u> E. <u>5</u> _____ miles _____ of <u>Wall Hill</u> (distance) (direction) (nearest town) | <u>Red Clay</u> | <u>0</u> | <u>10</u> |
| WELL PURPOSE: <u>Home</u> (home, irrigation, municipal, industrial) | <u>Red Clay Sand</u> | <u>10</u> | <u>30</u> |
| WELL COMPLETION DATA: (1) diameter (inches) <u>4</u> | <u>Red Sand</u> | <u>30</u> | <u>90</u> |
| (2) total depth (feet) <u>127</u> | <u>White Sand</u> | <u>90</u> | <u>127</u> |
| (3) static water level (feet) <u>88</u> below above top of ground. | | | |
| (4) casing <u>PVC</u> , <u>127</u> , (material) (depth) _____ if telescope see back. (size) | | | |
| (5) screen <u>7</u> , <u>120</u> (length) (depth to top) <u>4</u> , <u>granite type</u> (size) (material) | | | |
| (6) pump <u>1/2</u> , <u>10</u> (HP) (yield gpm) <u>220V</u> (type power) | | | |
| (7) electric log <u>No</u> (yes or no) | | | |
| (8) how well bottom plugged <u>Cap</u> | | | |
| DRILLERS REMARKS: | | | |


RECEIVED

JUN 29 1978

MISS. BD. OF WATER COMMISSIONERS

If well telescopes please sketch and show depths.

GROUND LEVEL

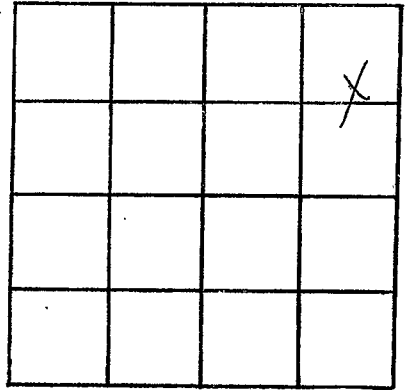

SECTION 11

Please indicate well location X.

ADDITIONAL INFORMATION

If more than one screen,
show locations of each on sketch.