

Marshall  
M  
2016  
11-2-79  
11-2- 19

MISSISSIPPI  
 BOARD OF WATER COMMISSIONERS  
 416 North State Street  
 Jackson, Mississippi 39201

WATER WELL DRILLERS LOG

date well completed

firm name

county well located

79 Richards Wells Marshall

LANDOWNER:	description of formations encountered	from	to
<u>Hattie Newman</u>			
<u>Rt 4 - Caldwellwater Miss</u> (mailing address)	<u>Clay</u>	<u>0</u>	<u>40</u>
WELL LOCATION: sec. <u>14</u> T. <u>4</u> N R. <u>5</u> E <u>Walhill</u> miles of (direction) (nearest town)	<u>red sand</u>	<u>40</u>	<u>90</u>
WELL PURPOSE: <u>home</u> (home, irrigation, municipal, industrial)	<u>white sand</u>	<u>90</u>	<u>155</u>
WELL COMPLETION DATA: (1) diameter (inches) <u>4 in</u>			
(2) total depth (feet) <u>155</u>			
(3) static water level (feet) _____ below/above top of ground.			
(4) casing <u>Plastic</u> , <u>155</u> (material) (depth)			
(size) if telescope see back.			
(5) screen <u>7 ft</u> , <u>148</u> (length) (depth to top)			
<u>4 in</u> , <u>Gravel</u> (size) (material)			
(6) pump <u>1/2</u> , <u>10</u> (HP) (yield gpm)			
<u>280</u> (type power)			
(7) electric log <u>No</u> (yes or no)			
(organization running log)			
(8) how well bottom plugged <u>Cap.</u>			
DRILLERS REMARKS:			


DEPT. OF NATURAL RESOURCES  
 BUREAU OF LAND & WATER RESOURCES

NOV 13 1979

RECEIVED

If well telescopes please sketch and show depths.

GROUND LEVEL

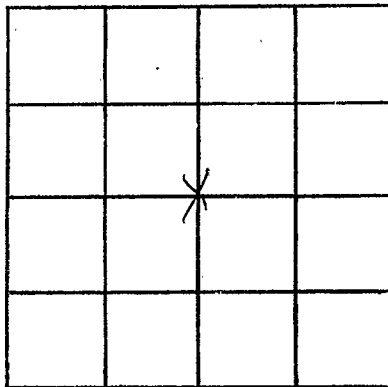

SECTION 14

Please indicate well location X.

ADDITIONAL INFORMATION

If more than one screen, show locations of each on sketch.