

MISSISSIPPI DEPARTMENT OF NATURAL RESOURCES

Bureau of Land and Water Resources

Southport Mall

P.O. Box 10631

Jackson, Mississippi 39209

WATER WELL DRILLERS LOG

MARSHALL
M 2017
4/10/81
4/10/0

3

date well completed 4/10/0 1981
firm name E. J. Gullett Well Drilling
county well located Marshall

LANDOWNER: E. J. Gullett

description of formations encountered	from	to
top	0	5
clay	5	30
sand and clay	30	80
white sand	80	140

(mailing address)

WELL LOCATION:

sec. 2 T. 4 N. R. 5 E. S. 73 W. 5
2 miles S of Fralor
(distance) (direction) (nearest town)

WELL PURPOSE:

(home, irrigation, municipal, industrial)

WELL COMPLETION DATA:

- (1) diameter (inches) 4
- (2) total depth (feet) 140
- (3) static water level (feet) 90 below top of ground.
- (4) casing PVC 130 (material) (depth)
- (5) screen 10 (length) 140 to 130 (depth to top)
- (6) pump 4 (size) PVC (material)
- (7) pump 1/2 (HP) 10 (yield gpm)
- (8) electric log X (yes or no)

(organization running log)

(8) how well bottom plugged Completed

DRILLERS REMARKS:


DEPT. OF NATURAL RESOURCES
BUREAU OF LAND & WATER RESOURCES

MAY 18 1981

RECEIVED

If well telescopes please sketch and show depths.

GROUND LEVEL

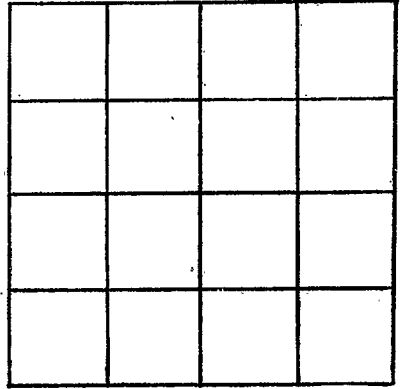

SECTION _____

Please indicate well location X.

ADDITIONAL INFORMATION

If more than one screen,
show locations of each on sketch.