

MISSISSIPPI DEPARTMENT OF NATURAL RESOURCES

Bureau of Land and Water Resources

Southport Mall

P.O. Box 10631

Jackson, Mississippi 39209

WATER WELL DRILLERS LOG

Marshall
M 2018
4/12/81

4/12/81 19 81 Bullett well logs Marshall
date well completed firm name county well located

LANDOWNER: S. Sonders

description of formations encountered	from	to
	<u>Top</u>	<u>0</u>

(mailing address)

WELL LOCATION:
sec. 2 T. 4 N. R. 5 E.
45 S. 5 W.
2 miles S of Watson
(distance) (direction) (nearest town)

<u>Clay</u>	<u>5</u>	<u>30</u>
<u>Sand on clay</u>	<u>30</u>	<u>80</u>
<u>white sand</u>	<u>80</u>	<u>148</u>

WELL PURPOSE:
(home, irrigation, municipal, industrial)

WELL COMPLETION DATA:

- (1) diameter (inches) 4
- (2) total depth (feet) 140'
- (3) static water level (feet) 90 below above top of ground.
- (4) casing PVC 130
(material) (depth)
4"
(size) if telescope see back.
- (5) screen 10' 130 to 140
(length) (depth to top)
4" PVC
(size) (material)
- (6) pump 1/2 10
(HP) (yield gpm)
electric
(type power)
- (7) electric log X
(yes or no)
(organization running log)
- (8) how well bottom plugged Complete


DRILLERS REMARKS:

DEPT. OF NATURAL RESOURCES
BUREAU OF LAND & WATER RESOURCES
JACKSON, MISSISSIPPI

MAY 18 1981
RECEIVED

If well telescopes please sketch and show depths.

GROUND LEVEL

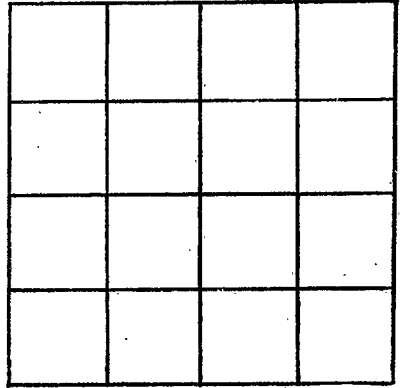

SECTION _____

Please indicate well location X.

ADDITIONAL INFORMATION

If more than one screen,
show locations of each on sketch.