

MISSISSIPPI DEPARTMENT OF NATURAL RESOURCES

Bureau of Land and Water Resources

Southport Mall

P.O. Box 10631

Jackson, Mississippi 39209

WATER WELL DRILLERS LOG

MARSHALL
M 2019
4-22-81

4-22-81 date well completed Hicks Well Co. firm name Marshall county well located

LANDOWNER: Barbara Klouance
Rt. 3
Box 381, Mrs. 38611
 (mailing address)

description of formations encountered	from	to
Red Sand & Clay	0	40
white sand	40	150

WELL LOCATION:
 sec. 11 T. 4 N. R. 5 E.
1 miles NW of Pidgeon Roost
 (distance) (direction) (nearest town)


WELL PURPOSE: Home
 (home, irrigation, municipal, industrial)

- WELL COMPLETION DATA:
- (1) diameter (inches) 4
 - (2) total depth (feet) 100
 - (3) static water level (feet) 60 below above top of ground.
 - (4) casing PVC 150
 (material) (depth)
 - (size) if telescope see back.
 - (5) screen 7 19.3
 (length) (depth to top)
 - 4" gravel type
 (size) (material)
 - (6) pump 1/2 10
 (HP) (yield gpm)
 - 220V
 (type power)
 - (7) electric log No
 (yes or no)

(organization running log)


(8) how well bottom plugged Cap

DRILLERS REMARKS:

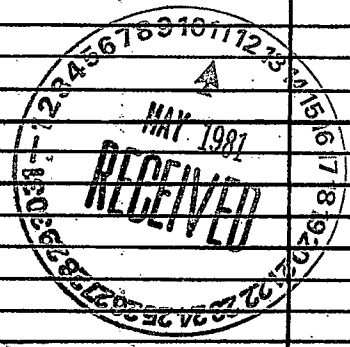

If well telescopes please sketch and show depths.

GROUND LEVEL

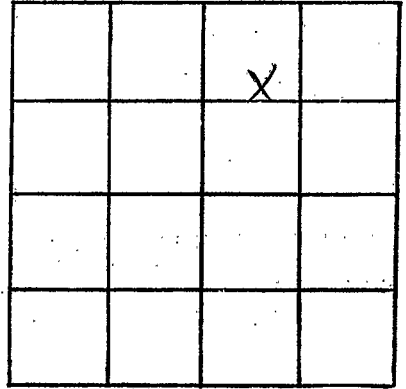

SECTION 11

Please indicate well location X.

ADDITIONAL INFORMATION

If more than one screen, show locations of each on sketch.