

MISSISSIPPI DEPARTMENT OF NATURAL RESOURCES
Bureau of Land and Water Resources
 Southport Mall
 P.O. Box 10631
 Jackson, Mississippi 39209
WATER WELL DRILLERS LOG

Marshall
M
2020

date well completed 6-6 1983 NICKS WELL CO Marshall
Rt. 1, Orange county well located

LANDOWNER: Jody Nealey
4880 Scottsdale
Memphis, Tenn.
(mailing address)

description of formations encountered	from	to
<u>Red Clay</u>	<u>0</u>	<u>20</u>
<u>Red Sand</u>	<u>20</u>	<u>60</u>
<u>White Sand</u>	<u>60</u>	<u>150</u>

WELL LOCATION:
 sec. 25 T. 4 N. R. 5 E.
1 1/2 miles E of Wall Hill
(distance) (direction) (nearest town)

WELL PURPOSE: Home
(home, irrigation, municipal, industrial)

WELL COMPLETION DATA:

- (1) diameter (inches) 4"
- (2) total depth (feet) 150"
- (3) static water level (feet) 80 below above top of ground.
- (4) casing PVC, 150'
(material) (depth)
4"
(size) if telescope see back.
- (5) screen 10' 140'
(length) (depth to top)
.013 PVC
(size) (material)
- (6) pump 1/2 10
(HP) (yield gpm)
220V
(type power)
- (7) electric log No
(yes or no)
(organization running log)
- (8) how well bottom plugged Cap

DRILLERS REMARKS:


DEPT. OF NATURAL RESOURCES
 BUREAU OF LAND & WATER RESOURCES

JUN 27 1983

RECEIVED

If well telescopes please sketch and show depths.

GROUND LEVEL

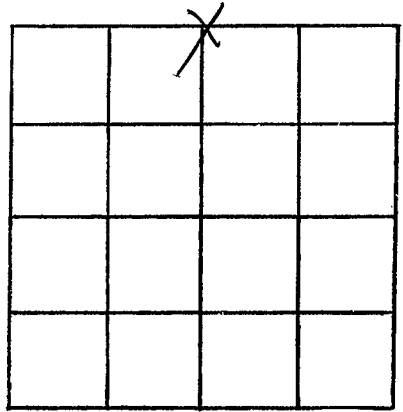

SECTION 25

Please indicate well location X.

ADDITIONAL INFORMATION

If more than one screen
show locations of each on sketch.