

MISSISSIPPI DEPARTMENT OF NATURAL RESOURCES

Bureau of Land and Water Resources

Southport Mall

P.O. Box 10631

Jackson, Mississippi 39209

WATER WELL DRILLERS LOG

Marshall
M
2021

12/14 1983
date well completed

Marshall
firm name

Marshall
county well located

LANDOWNER: Milton Sharp
Rt. 4
Byrdville, Mo. 38611
(mailing address)

description of formations encountered	from	to
<u>Red Clay</u>	<u>0</u>	<u>20</u>
<u>Red Sand</u>	<u>20</u>	<u>35</u>
<u>Red Sand + clay</u>	<u>35</u>	<u>80</u>
<u>White Sand + clay</u>	<u>80</u>	<u>110</u>
<u>White Sand</u>	<u>110</u>	<u>145</u>

WELL LOCATION:
sec. 14 T 4 N R 5 E
1 1/2 miles W Math. Cove
(distance) (direction) (nearest town)

WELL PURPOSE: Home
(home, irrigation, municipal, industrial)

WELL COMPLETION DATA:

(1) diameter (inches) 4

(2) total depth (feet) 145

(3) static water level (feet) 80 below above top of ground

(4) casing PVC 145
(material) (depth)
4' If telescope see back.
(size)

(5) screen 10' 135'
(length) (depth to top)
1010 PVC
(size) (material)

(6) pump 1/2 10
(HP) (yield gpm)
220V
(type power)

(7) electric log No
(yes or no)
Cap
(organization running log)

(8) how well bottom plugged Cap

DRILLERS REMARKS:


DEPT. OF NATURAL RESOURCES
BUREAU OF LAND & WATER RESOURCES

JAN 9 - 1984

RECEIVED

If well telescopes please sketch and show depths.

GROUND LEVEL

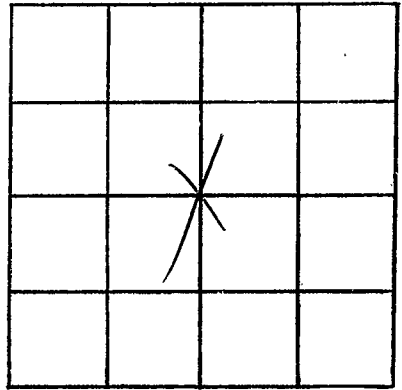

SECTION 14

Please indicate well location X.

ADDITIONAL INFORMATION

If more than one screen,
show locations of each on sketch.