

MISSISSIPPI DEPARTMENT OF NATURAL RESOURCES

Bureau of Land and Water Resources

Southport Mall

P.O. Box 10631

Jackson, Mississippi 39209

WATER WELL DRILLERS LOG

MARSHALL

M 2022

WATERS WELL CO.

Rt. 1, Box 157

Senatobia, MS 38683

Marshall

6/4 1984  
date well completed

county well located


LANDOWNER: <u>Sam Freeman</u> <u>Rt. 4 Box 495</u> <u>Byhalia, Ms. 38611</u> (mailing address)	description of formations encountered	from	to
	Red Clay	0	20
	Red Sand	20	60
WELL LOCATION: sec. <u>10</u> T <u>4</u> N R <u>5</u> E <u>2</u> miles <u>N</u> of <u>Wall Hill</u> (distance) (direction) (nearest town)	white sand & Clay	60	125
	white sand	125	140
WELL PURPOSE: <u>Home</u> (home, irrigation, municipal, industrial)			
WELL COMPLETION DATA: (1) diameter (inches) <u>4</u> (2) total depth (feet) <u>140</u> (3) static water level (feet) <u>80</u> <u>below</u> <u>above</u> top of ground. (4) casing <u>PVC</u> , <u>140'</u> (material) (depth) <u>4"</u> <u>if telescope see back.</u> (size) (5) screen <u>10'</u> , <u>130'</u> (length) (depth to top) <u>1/2"</u> , <u>PVC</u> (size) (material) (6) pump <u>1/2</u> , <u>10</u> (HP) (yield gpm) <u>220V</u> (type power) (7) electric log <u>No</u> (yes or no) (organization running log) (8) how well bottom plugged <u>Cap</u>			
DRILLERS REMARKS:			

DEPT. OF NATURAL RESOURCES  
BUREAU OF LAND & WATER RESOURCES

JUL 10 1984  
RECEIVED

If well telescopes please sketch and show depths.

GROUND LEVEL

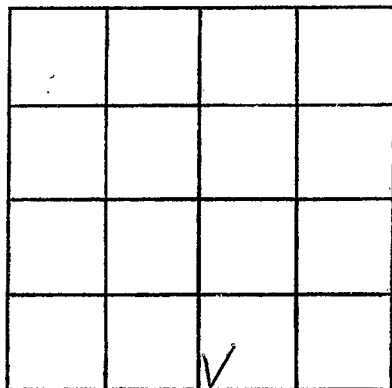

SECTION 10

Please indicate well location X.

ADDITIONAL INFORMATION

If more than one screen, show locations of each on sketch.