

MISSISSIPPI DEPARTMENT OF NATURAL RESOURCES

Bureau of Land and Water Resources

Southport Mall

P.O. Box 10631

Jackson, Mississippi 39209

WATER WELL DRILLERS LOG

MARSHALL
M 2023

6/29 1984
date well completed

HICKS WELL CO.
firm name 157

Marshall
county well located

LANDOWNER:	description of formations encountered	from	to
Ethel Jones Pt. 4	Red Clay	0	15
Buhala, Ms. 30611 (mailing address)	Red Sand	15	60
WELL LOCATION: sec. 26 T 4 N R 5 E 1/2 miles E of Wall Hill (distance) (direction) (nearest town)	White Sand & Clay	60	110
	White Sand	110	165

WELL PURPOSE: home
(home, irrigation, municipal, industrial)

- WELL COMPLETION DATA:
- (1) diameter (inches) 4
 - (2) total depth (feet) 165
 - (3) static water level (feet) 100 ^{below} _{above} top of ground.
 - (4) casing PVC, 165
(material) (depth)
 - 4 If telescope see back.
(size)
 - (5) screen 10 155
(length) (depth to top)
 - 010 PVC
(size) (material)
 - (6) pump 1/2 10
(HP) (yield gpm)
 - 2200
(type power)
 - (7) electric log No
(yes or no)

(organization running log)

(8) how well bottom plugged Cap

DRILLERS REMARKS:


DEPT. OF NATURAL RESOURCES
BUREAU OF LAND & WATER RESOURCES

JUL 10 1984

RECEIVED

If well telescopes please sketch and show depths.

GROUND LEVEL

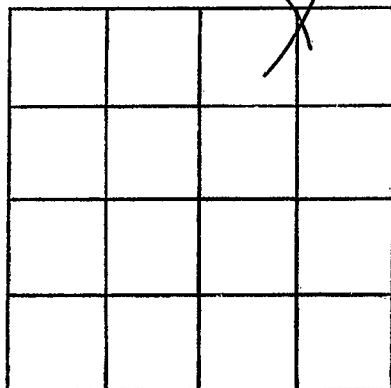

SECTION 26

Please indicate well location X.

ADDITIONAL INFORMATION

If more than one screen,
show locations of each on sketch.