

MISSISSIPPI DEPARTMENT OF NATURAL RESOURCES

Bureau of Land and Water Resources

Southport Mall

P.O. Box 10631

Jackson, Mississippi 39209

WATER WELL DRILLERS LOG

Marshall  
M  
2024

7-29 19 84  
 date well completed

HICKS WELL CO.  
 drilling name


Marshall  
 county well located

LANDOWNER: <u>Jack Hiken</u> <u>Rt. 4</u>	description of formations encountered	from	to
<u>Bghalia, Ms. 38611</u> (mailing address)	<u>Red Clay</u>	<u>0</u>	<u>10</u>
WELL LOCATION: sec. <u>11</u> T <u>4</u> N R <u>5</u> E <u>2</u> miles <u>N</u> of <u>Wall Hill</u> (distance) (direction) (nearest town)	<u>Red Sand</u>	<u>10</u>	<u>30</u>
WELL PURPOSE: <u>Home</u> (home, irrigation, municipal, industrial)	<u>white sand</u>	<u>30</u>	<u>110</u>
WELL COMPLETION DATA:			
(1) diameter (inches) <u>4"</u>			
(2) total depth (feet) <u>110</u>			
(3) static water level (feet) <u>60</u> <sup>below</sup> / <sub>above</sub> top of ground.			
(4) casing <u>PVC</u> , <u>110</u> , (material) (depth)			
<u>4"</u> If telescope see back. (size)			
(5) screen <u>10'</u> , <u>100'</u> (length) (depth to top)			
<u>1010</u> <u>PVC</u> (size) (material)			
(6) pump <u>1/2</u> , <u>10</u> (HP) (yield gpm)			
<u>2200</u> (type power)			
(7) electric log <u>No</u> (yes or no)			
(organization running log)			
(8) how well bottom plugged <u>Cap</u>			
DRILLERS REMARKS:			

DEPT. OF NATURAL RESOURCES  
 BUREAU OF LAND & WATER RESOURCES  
 RECEIVED  
 SEP 24 1984

If well telescopes please sketch and show depths.

GROUND LEVEL

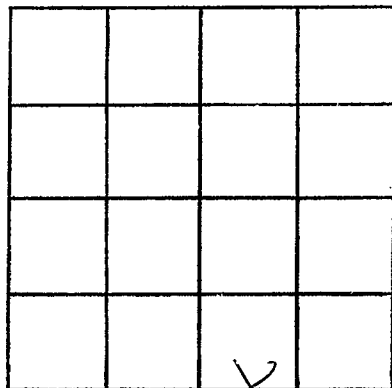

SECTION 11

Please indicate well location X.

ADDITIONAL INFORMATION

If more than one screen,  
show locations of each on sketch.