

MISSISSIPPI DEPARTMENT OF NATURAL RESOURCES

Bureau of Land and Water Resources

Southport Mall

P.O. Box 10631

Jackson, Mississippi 39209

WATER WELL DRILLERS LOG

Marshall
M
2025

WATER WELL CO.

Marshall
 county well located

10-14 1984
 date well completed

firm name

LANDOWNER: Eva Malone
Rt. 4 Box 304
Coldwater, Ms. 38618
 (mailing address)

description of formations encountered

from

to

WELL LOCATION:
 sec. 22 T 4 N R 5 E
1 miles W of Wall Hill
 (distance) (direction) (nearest town)

Red Clay

0 10

Red & White Clay

10 150

white sand

150 175

Clay & Sand

175 185

WELL PURPOSE: Home
 (home, irrigation, municipal, industrial)

WELL COMPLETION DATA:

(1) diameter (inches) 4
 (2) total depth (feet) 185

(3) static water level (feet) 100 ~~below~~ above top of ground.

(4) casing PVC, 185
 (material) (depth)

4"
 (size) if telescope see back.

(5) screen 15', 150'
 (length) (depth to top)

old, PVC
 (size) (material)

(6) pump 1/2, 10
 (HP) (yield gpm)

220V
 (type power)

(7) electric log No
 (yes or no)

(organization running log)

(8) how well bottom plugged Cap

DRILLERS REMARKS:


DEPT. OF NATURAL RESOURCES
 BUREAU OF LAND & WATER RESOURCES

NOV 28 1984

RECEIVED

If well telescopes please sketch and show depths.

GROUND LEVEL

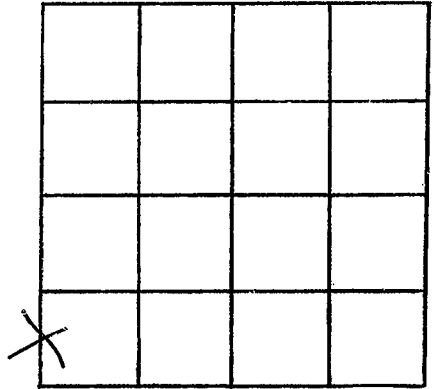

SECTION 22

Please indicate well location X.

ADDITIONAL INFORMATION

If more than one screen,
show locations of each on sketch.