

MISSISSIPPI DEPARTMENT OF NATURAL RESOURCES

Bureau of Land and Water Resources

Southport Mall

P.O. Box 10631

Jackson, Mississippi 39209

WATER WELL DRILLERS LOG

Marshall  
M  
2026

7-24 1986 Gullett White Well Marshall  
 date well completed firm name county well located

LANDOWNER: Ed Grace  
Rt 4 Wall Hill Rd.  
Byhalia, Mo  
 (mailing address)

description of formations encountered

from to

<u>top soil</u>	<u>0</u>	<u>3'</u>
<u>red clay</u>	<u>3'</u>	<u>20'</u>
<u>white sand clay</u>	<u>20'</u>	<u>100'</u>
<u>white sand</u>	<u>100</u>	<u>140'</u>

WELL LOCATION:

sec. 26 4 N R. 5 E  
8 miles West of Marion  
 (distance) (direction) (nearest town)


WELL PURPOSE: home  
 (home, irrigation, municipal, industrial)

WELL COMPLETION DATA:

- (1) diameter (inches) 4"
- (2) total depth (feet) 140
- (3) static water level (feet) 90 below top of ground.
- (4) casing PVC, 130',  
 (material) (depth)  
4" If telescope see back.  
 (size)
- (5) screen 10', 130'  
 (length) (depth to top)  
4", PVC  
 (size) (material)
- (6) pump 1/2, 10  
 (HP) (yield gpm)  
Elec  
 (type power)
- (7) electric log No  
 (yes or no)

(organization running log)

(8) how well bottom plugged Cap

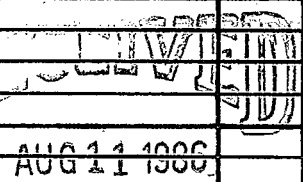


Department of Natural Resources  
 Bureau of Land & Water Resources

DRILLERS REMARKS:

If well telescopes please sketch and show depths.

GROUND LEVEL

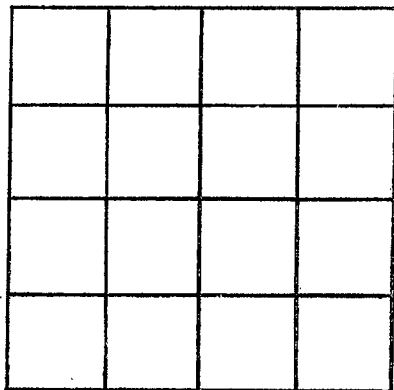

SECTION \_\_\_\_\_

Please indicate well location X.

ADDITIONAL INFORMATION

If more than one screen,  
show locations of each on sketch.