

MISSISSIPPI DEPARTMENT OF NATURAL RESOURCES

Bureau of Land and Water Resources

COUNTY WELL LOCATED Marshall	
WELL NUMBER M 2051	CODED
DATE WELL COMPLETED 5-21-90	

PERMIT NUMBER HICKS WELL CO.
NAME OF DRILLING FIRM RTM BOX 157 OSHTOBIJA, MS 38698

P.O. Box 10631
Jackson, Mississippi 39209
WATER WELL DRILLERS LOG

NAME & MAILING ADDRESS OF LANDOWNER D. F. HUNT Olive Branch MS.		
WELL LOCATION: SEC	TOWNSHIP	RANGE
23	4	5
DISTANCE DIRECTION NEAREST TOWN 16 Miles E of Caldwell		
OTHER LANDMARK ON CO. LINE RD		
WELL PURPOSE (Home, Irrigation, Municipal, Industrial, Fish Pond, etc.) Irrigation		

PUMP DATA		
PUMP TYPE (Circle One): <input checked="" type="checkbox"/> Submersible Turbine, Jet Flowing Well, Other (Describe) _____		
POWER TYPE (Circle One): <input checked="" type="checkbox"/> Electric Tractor, Diesel, Gasoline, Butane, Other (Describe) _____ H/P 1/2		
Pump Capacity (GPM) 10	No. of Stages 9	Setting Depth 120 FT.
PUMP TEST Well yielded 10 GPM with a drawdown of _____ ft. after _____ hours of pumping		

WELL DATA		
Well Depth 130	Casing Diameter (In.) 4"	Casing Length (Ft.) 120'
Type of Casing PVC	Hole Depth 130	Depth to Static Water Level 90
TYPE OF COMPLETION: (Circle One or More): <input checked="" type="checkbox"/> Gravel Packed Underreamed, Telescoped, Natural Development, Open Hole, Other (Describe) _____		
Top of Lap Pipe or Reduction in Casing FEET <input type="checkbox"/> IF TELESCOPED OR MORE THAN ONE SCREEN: USE BACK PAGE		

LOG DATA	
TYPE OF LOG RUN (Circle One): Electric, Gamma Ray, Density, Sonic, Neutron, Other (Describe) _____ No Log Run	
Name of Organization Running Log	

SCREEN DATA		
Diameter - Inches 4"	Length - Feet 10'	Slot Size - Inches 013
Screen Type PVC	Depth to Bottom - Feet 10'	


GEOLOGIC DATA (Office Use Only)			
Surface Elev.	Geologic Unit	Unit Thickness	Depth to Top
Subs. SWL	Date	Analysis	Aquifer Test
Driller's Remarks			

DESCRIPTION OF FORMATIONS ENCOUNTERED	FROM	TO	FORMATIONS (Continued)	FROM	TO
RC	0	30	RECEIVED		
RC & S	30	90			
W S.	90	130			
			JUN 07 1990		
			Department of Natural Resources Bureau of Land & Water Resources		

IF MORE SPACE IS NEEDED, USE BACK

If well telescopes please
sketch and show depths.

GROUND LEVEL

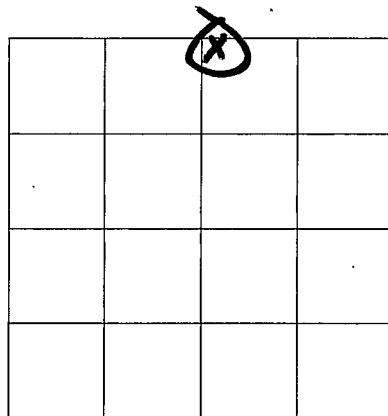

SECTION _____

Please indicate well location X.

ADDITIONAL INFORMATION

If more than one screen,
show location of each on sketch.