

MISSISSIPPI DEPARTMENT OF ENVIRONMENTAL QUALITY
Bureau of Land and Water Resources

P. O. Box 10631
Jackson, MS 39289-0631
WATER WELL DRILLERS LOG

COUNTY WELL LOCATED <i>Marshall</i>
WELL NUMBER <i>M 2056</i>
CODED
DATE WELL COMPLETED <i>7-9-92</i>

PERMIT NUMBER
NAME OF DRILLING FIRM HICKS WELL CO.
RT. 1 BOX 157

NAME & MAILING ADDRESS OF LANDOWNER <i>John O Adams</i>			
<i>RT 3</i>			
<i>Byhalia, MS</i>			
WELL LOCATION: SEC	TOWNSHIP	RANGE	
<i>26</i>	<i>4</i>	<i>5</i>	
DISTANCE	DIRECTION	NEAREST TOWN	
<i>12</i> Miles	<i>S/W</i> of	<i>Byhalia</i>	
OTHER LANDMARK			
WELL PURPOSE: <input checked="" type="radio"/> Home Irrigation, Municipal, Industrial, Fish Pond, etc.			

PUMP DATA		
PUMP TYPE (Circle One): <input checked="" type="radio"/> Submersible Turbine Jet Flowing Well, Other (Describe) _____		
POWER TYPE (Circle One): <input checked="" type="radio"/> Electric Tractor Diesel Gasoline Butane, Other (Describe) _____ H/P <i>1/2</i>		
Pump Capacity (GPM) <i>100</i>	No. of Stages <i>9</i>	Setting Depth <i>140</i> FT.
PUMP TEST		
Well yielded _____ GPM with a drawdown of _____ ft. after _____ hours of pumping		

WELL DATA		
Well Depth <i>200</i>	Casing Diameter (In.) <i>4"</i>	Casing Length (Ft.) <i>190</i>
Type of Casing <i>PVC</i>	Hole Depth <i>200</i>	Depth to Static Water Level <i>120</i>
TYPE OF COMPLETION: (Circle One or More): <input checked="" type="radio"/> Gravel Packed Underreamed Telescoped, Natural Development, Open Hole, Other (Describe) _____		
Top of Lap Pipe or Reduction in Casing FEET IF TELESCOPED OR MORE THAN ONE SCREEN: USE BACK PAGE		

LOG DATA	
TYPE OF LOG RUN (Circle One): No Log Run, Electric, Gamma Ray, Density, Sonic, Neutron, Other (Describe) _____	
Name of Organization Running Log	

SCREEN DATA		
Diameter - Inches <i>4"</i>	Length - Feet <i>10'</i>	Slot Size - Inches <i>013</i>
Screen Type <i>PVC</i>	Depth to Bottom - Feet <i>10'</i>	

GEOLOGIC DATA (Office Use Only)			
Surface Elev.	Geologic Unit	Unit Thickness	Depth to Top
Subs. SWL	Date	Analysis	Aquifer Test
Driller's Remarks			


DESCRIPTION OF FORMATIONS ENCOUNTERED	FROM	TO
<i>SAND & CLAY</i>	<i>0</i>	<i>80</i>
<i>CLAY</i>	<i>80</i>	<i>160</i>
<i>W/S</i>	<i>160</i>	<i>200</i>

FORMATIONS (Continued)	FROM	TO
RECEIVED		
OCT 22 1992		
Dspt. of Environmental Quality		
Bureau of Land & Water Resources		

IF MORE SPACE IS NEEDED, USE BACK

If well telescopes please
sketch and show depths.

GROUND LEVEL

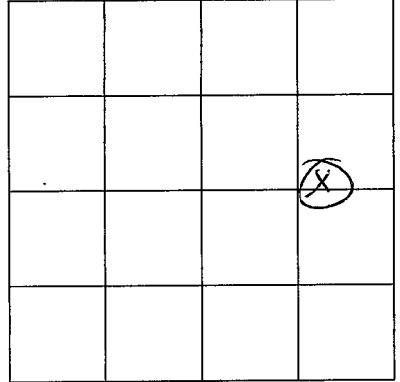

SECTION _____

Please indicate well location X.

ADDITIONAL INFORMATION

Multiple horizontal lines for providing additional information.

If more than one screen,
show location of each on sketch.