

N4
12-3-63

WATER WELL DRILLERS LOG

CODED

Date: 12-3, 1963, Driller: Adams Bros. Co. Inc. County Marshall
(Name)

(1) Owner of Land: Emmitt Jones
(Name)
Holly Springs, Ate 3
(Address)

(2) Location: 1/4, 1/4, 34 7 4 Sec. 7 R
_____ miles _____ of _____
(distance) (direction) (Nearest Town)

(3) Topography: _____
(Hilly) (Flat) (Level)

(4) Purpose of Well: _____
(Domestic Irrigation, Municipal, Industrial, Other)

Description & Color of Materials Sand, Clay, Red Clay, Shell, etc.	Thick- ness Feet	Depth Feet
<u>top soil</u>	<u>0</u>	<u>20</u>
<u>red sand</u>	<u>20</u>	<u>80</u>
<u>fine white sand</u>	<u>80</u>	<u>140</u>
<u>fine sand & clay</u>	<u>140</u>	<u>185</u>
<u>medium white sand</u>	<u>185</u>	<u>195</u>
<u>good coarse sand</u>	<u>195</u>	<u>212</u>

Information upon completion of well:

(1) Diameter 4 inches.


(2) Total Depth 212 feet.

(3) Water Level 120 feet below top of ground.

(4) Cased to 198, Size _____

(5) Screen: Size 4", Length 14'

(6) Were any formations sealed against pollution?
_____ yes, _____ no.

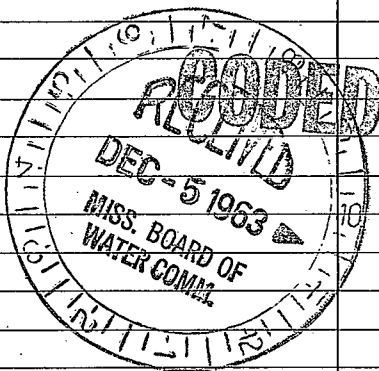

If YES depth of formation _____

Why _____

Drillers Remarks: _____

(Use Back Side)

Well No.

[The page contains extremely faint and illegible text, likely bleed-through from the reverse side of the document. No specific content can be transcribed.]