

CODED

Marshall
N 5
6-6-69

MISSISSIPPI
BOARD OF WATER COMMISSIONERS
416 North State Street
Jackson, Mississippi 39201

CODED

WATER WELL DRILLERS LOG

June 6 1969 R.L. Carpenter Marshall
date well completed firm name county well located

LANDOWNER: Fred Falgout
Holly Springs, Miss.
RFD
(mailing address)

description of formations encountered	from	to
Surface Soil	0	21
med white sand	21	65
white clay	65	89
white fine sand	89	121
white clay	121	140
white coarse sand	140	170

WELL LOCATION:
sec. 22 T. 4 N R. 4 E
S W
1/2 miles west of Moriana
(distance) (direction) (nearest town)

WELL PURPOSE: Home
(home, irrigation, municipal, industrial)

WELL COMPLETION DATA:

(1) diameter (inches) 4

(2) total depth (feet) 170

(3) static water level (feet) 110 below top of ground.

(4) casing Plastic, 164 ft.
(material) (depth)
(size) if telescope see back.

(5) screen 6 ft, 164 ft.
(length) (depth to top)
4 in. Plastic & Sand
(size) (material)

(6) pump 3/4 10
(HP) (yield gpm)
Elec.
(type power)

(7) electric log No
(yes or no)

(organization running log) Plastic Plug

(8) how well bottom plugged

DRILLERS REMARKS:


SEP 17 1969

MISS. B.L. 22
WATER COM.

If well telescopes please sketch and show depths.

GROUND LEVEL

R 4 W

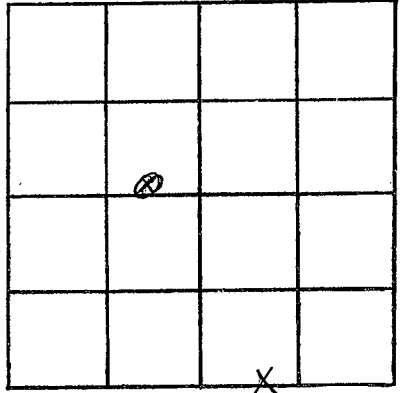

SECTION 22

Please indicate well location X.

ADDITIONAL INFORMATION

If more than one screen,
show locations of each on sketch.