

Marshall  
N 6  
11-13-69

MISSISSIPPI  
BOARD OF WATER COMMISSIONERS  
416 North State Street  
Jackson, Mississippi 39201

Recent  
CODED

WATER WELL DRILLERS LOG

Nov. 13th 1969 W.G. Mason - Water well Contractor  
date well completed firm name county well located Marshall


LANDOWNER: John Ingram Route 3	description of formations encountered	from	to
Bghalia Miss. 38611 (mailing address)	Extremely coarse		
WELL LOCATION: sec 6 T. 4 N R. 4 E 2 1/2 miles SE of Watson (distance) (direction) (nearest town)	gray water sand	23	25
WELL PURPOSE: TEENY HOUSE (home, irrigation, municipal, industrial)			
WELL COMPLETION DATA:			
(1) diameter (inches) 4"			
(2) total depth (feet) 25			
(3) static water level (feet) 16 below above top of ground.			
(4) casing PVC Plastic 25 (material) (depth) 4" (size) if telescope see back.			
(5) screen none (length) (depth to top) (size) (material)			
(6) pump none (HP) (yield gpm) (type power)			
(7) electric log no (yes or no) (organization running log)			
(8) how well bottom plugged not			
DRILLERS REMARKS:			

DEC - 1 1969

MISS. BD. OF  
WATER COMMISSIONERS

If well telescopes please sketch and show depths.

GROUND LEVEL

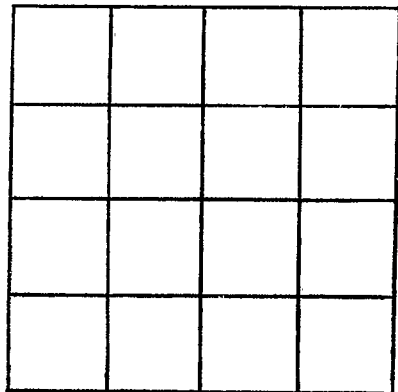

SECTION \_\_\_\_\_

Please indicate well location X.

ADDITIONAL INFORMATION

put 4" PVC casing  
inside old tile  
well & pumped  
about two feet  
below old tile  
curb, old well was  
made by Dock  
Mason approximately  
30 years ago

If more than one screen,  
show locations of each on sketch.