

Marshall
N 7
9-10-69

MISSISSIPPI
 BOARD OF WATER COMMISSIONERS
 416 North State Street
 Jackson, Mississippi 39201

CODED

CODED

WATER WELL DRILLERS LOG.

9-10-1969 date well completed Robert W. Wilson firm name Marshall county well located

LANDOWNER: Lavan Miller
Holly Springs
Miss
 (mailing address)

description of formations encountered	from	to
<u>Red Clay Red sand</u>	<u>0</u>	<u>20</u>
<u>Red sand</u>	<u>20</u>	<u>180</u>
<u>Red sand white clay white sand</u>	<u>180</u>	<u>190</u>
<u>white sand white clay</u>	<u>190</u>	<u>220</u>
<u>white sand</u>	<u>220</u>	<u>240</u>

WELL LOCATION:
 sec. 7 T. 4 N. S R. 4 E. W
 (distance) miles _____ of _____ (direction) (nearest town)

WELL PURPOSE:
 (home, irrigation, municipal, industrial)

- WELL COMPLETION DATA:
- (1) diameter (inches) 4
 - (2) total depth (feet) 240
 - (3) static water level (feet) 190 below top of ground.
 - (4) casing Plastic (material) 236 (depth)
4" (size) if telescope see back.
 - (5) screen 4' (length) 236 (depth to top)
4" (size) Gravel Pack (material)
 - (6) pump 3/4 (HP) 15 (yield gpm)
Electric (type power)
 - (7) electric log no (yes or no)
 (organization running log)
 - (8) how well bottom plugged 4"
Plastic Cap


DRILLERS REMARKS:

DEC 20 1969

MISS. BD. OF
 WATER COMMISSIONERS

If well telescopes please sketch and show depths.

GROUND LEVEL

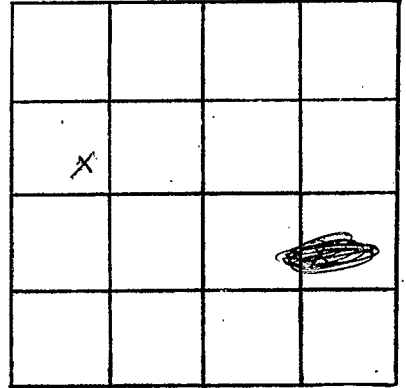

SECTION _____

Please indicate well location X.

ADDITIONAL INFORMATION

If more than one screen,
show locations of each on sketch.