

Recon

Marshall
N 8
1-5-70

MISSISSIPPI
BOARD OF WATER COMMISSIONERS
416 North State Street
Jackson, Mississippi 39201

CODED

WATER WELL DRILLERS LOG

W. A. MASON

January 5th, 1970 date well completed
W. A. MASON firm name
Marshall county well located


LANDOWNER:	description of formations encountered	from	to
Mrs. Velma A. Baldwin Artha Florida (mailing address)	Faintly coarse yellow		
WELL LOCATION: sec. 22 T. 4 N R. 4 E 3/4 miles West of Marianna (distance) (direction) (nearest town)	water bearing sand	81	85
WELL PURPOSE: <u>TEENAGE HOUSE</u> (home, irrigation, municipal, industrial) <u>LOUIS MCKINNEY</u>			
WELL COMPLETION DATA:			
(1) diameter (inches) <u>4"</u>			
(2) total depth (feet) <u>85'</u>			
(3) static water level (feet) <u>71</u> below top of ground.			
(4) casing <u>styrene plastic</u> (material) <u>85'</u> (depth)			
<u>4"</u> (size) if telescope see back.			
(5) screen <u>none</u> (length) (depth to top)			
(size) (material)			
(6) pump <u>none</u> (HP) (yield gpm)			
(type power)			
(7) electric log (yes or no)			
(organization running log)			
(8) how well bottom plugged <u>not</u>			
DRILLERS REMARKS:			

JAN - 8 1970

MISS. BD. OF

If well telescopes please sketch and show depths.

GROUND LEVEL

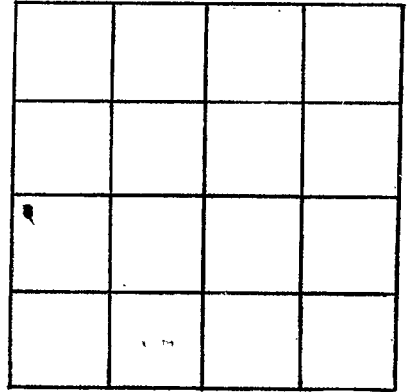

SECTION 22

Please indicate well location X.

ADDITIONAL INFORMATION

PUT 4" plastic casing inside old square concrete well & pumped down 4 FT. below old well
old well made by Clarence Jones in 1953, & Recorded by me Aug. 1964
Ref. page 177

If more than one screen, show locations of each on sketch.