

Revised

Marshall
N 9
1-9-70

MISSISSIPPI
 BOARD OF WATER COMMISSIONERS
 416 North State Street
 Jackson, Mississippi 39201

CODED
 CODED

WATER WELL DRILLERS LOG

W. A. MASON
 WATER WELL CONTRACTOR

January 9 - 1970 date well completed *Marshall* county well located


LANDOWNER:	description of formations encountered	from	to
<i>Ozell J. Wilson</i>			
R.F.I.D. <i>Holly Springs Missi</i> (mailing address)	<i>coarse white water</i>		
WELL LOCATION: sec. <i>28</i> T. <i>4</i> N. R. <i>4</i> E (distance) miles (direction) of (nearest town)	<i>bearing surf 63.77</i>		
WELL PURPOSE: <i>tenant house</i> (home, irrigation, municipal, industrial)	<i>medium coarse pink</i>		
WELL COMPLETION DATA: (1) diameter (inches) <i>4</i> (2) total depth (feet) <i>80</i> (3) static water level (feet) <i>56</i> below/above top of ground. (4) casing (material) (depth) <i>styro plastic 80</i> <i>4"</i> (size) if telescope see back. (5) screen (length) (depth to top) <i>none</i> (6) pump (HP) (yield gpm) <i>none</i> (type power) (7) electric log (yes or no) <i>no</i> (organization running log) <i>none</i> (8) how well bottom plugged <i>no p</i>	<i>water bearing sand</i>	<i>77</i>	<i>80</i>
DRILLERS REMARKS:			

JAN 12 1970

MISS. BD. OF
 WATER COMM.

If well telescopes please sketch and show depths.

GROUND LEVEL

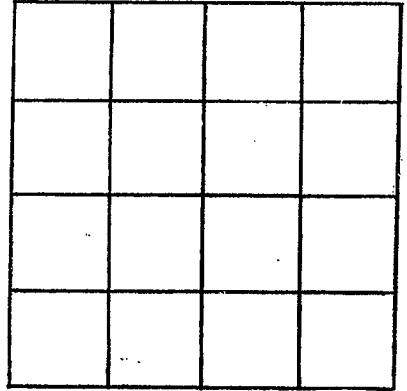

SECTION _____

Please indicate well location X.

ADDITIONAL INFORMATION

Put 4" plastic
inside of square
each well made
by me Aug-1962
Ref Page 77
For J. C. Tucker

If more than one screen,
show locations of each on sketch.