

Marshall
 N 10
 1-28-70

MISSISSIPPI
 BOARD OF WATER COMMISSIONERS
 416 North State Street
 Jackson, Mississippi 39201

Revised
CODED

WATER WELL DRILLERS LOG

Jan. 28 1970 ^{W. A. MASON} To water well contr. Marshall
 date well completed firm name county well located


LANDOWNER:	description of formations encountered	from	to
Mrs. Leonard Phillips P.O. Box Bayalia Miss. 38611 (mailing address)			
WELL LOCATION:			
sec. <u>21</u> T. <u>4</u> N. R. <u>4</u> E <u>2</u> miles <u>NW</u> of <u>Marianna</u> (distance) (direction) (nearest town)	water bearing sand	75	80
WELL PURPOSE: <u>Tenant House</u> (home, irrigation, municipal, industrial)			
WELL COMPLETION DATA:			
(1) diameter (inches) <u>4"</u>			
(2) total depth (feet) <u>80</u>			
(3) static water level (feet) <u>70</u> below top of ground.			
(4) casing <u>core plastic 80'</u> (material) (depth)			
<u>4"</u> (size) If telescope see back.			
(5) screen <u>none</u> (length) (depth to top)			
(size) (material)			
(6) pump <u>none</u> (HP) (yield gpm)			
(type power)			
(7) electric log <u>no</u> (yes or no)			
(organization running log)			
(8) how well bottom plugged <u>not</u>			
DRILLERS REMARKS:			

JAN 30 1970

MISS. BD. OF
 WATER COMM.

If well telescopes please sketch and show depths.

GROUND LEVEL

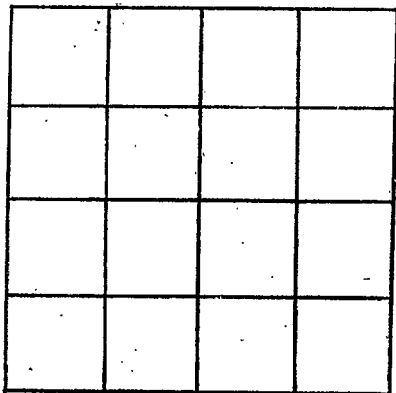

SECTION _____

Please indicate well location X.

ADDITIONAL INFORMATION

put 4" plastic casing inside of square curb well made by Dick Mason approx 30 years ago & pumped 5' below top well

If more than one screen, show locations of each on sketch.