

Marshall
N 12
3-10-70

At Keison + Frost
MISSISSIPPI
BOARD OF WATER COMMISSIONERS
416 North State Street
Jackson, Mississippi 39201

COPIED

WATER WELL DRILLERS LOG

3-10 date well completed
19 Ether F Walker firm name
MARSHALL county well located

LANDOWNER:
Ether F. Walker
R#5 Holly Springs
Miss. (mailing address)

description of formations encountered	from	to
Red Clay	0	15
Red Sand	15	80
White Sand	80	160

WELL LOCATION:
sec. 4 T 4 N R 4 E
(distance) miles of (direction) (nearest town)

WELL PURPOSE: Home
(home, irrigation, municipal, industrial)

- WELL COMPLETION DATA:
- (1) diameter (inches) 4"
 - (2) total depth (feet) 160
 - (3) static water level (feet) 145 below top of ground.
 - (4) casing PVC 150 (material) (depth)
 - (size) If telescope see back.
 - (5) screen 10 150 (length) (depth to top)
 - 6" Plastic (size) (material)
 - (6) pump 3 12 (HP) (yield gpm)
 - 230 (type power)
 - (7) electric log NO (yes or no)

COPIED

(organization running log)
(8) how well bottom plugged Plug


MAR 19 1970

DRILLERS REMARKS:

MISS. BD. OF
WATER COM.

If well telescopes please sketch and show depths.

GROUND LEVEL

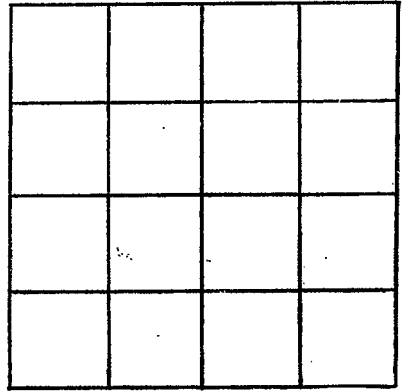

SECTION _____

Please indicate well location X.

ADDITIONAL INFORMATION

If more than one screen, show locations of each on sketch.